

1998 CHEBOYGAN COUNTY, STATE OF MICHIGAN REMONUMENTATION

RECORDED  
1998

LAND CORNER RECORDATION CERTIFICATE  
Filing Requirement of Act 74, Mich. P.A. 1970

SECTION

For corners in

Cheboygan  
(County)

Located In:

Corner Code #

Forest Township  
1. Public Land Survey

T	<u>34NR 1E</u>	<u>G-3</u>
T	_____	_____
T	_____	_____
T	_____	_____
S	_____	_____
S	_____	_____
S	_____	_____
S	_____	_____

2. Property Controlling in Section

3. Miscellaneous Property in Sec.

4. Lot No. \_\_\_\_\_, Recorded Plat \_\_\_\_\_  
5. Private Claims \_\_\_\_\_

RECEIVED FOR RECORD 12-7-98  
at 9:41 O'Clock A M

*Joanne Spray*

CLERK/REGISTER  
CHEBOYGAN COUNTY, MICHIGAN  
Register of Deeds Stamp & File Number

I, Ronald Bischer, in a field survey on 7-20, 1998 do hereby state that under requirements of P.A. 74, Michigan P.A. of 1970, the corner points mentioned in lines 1 and 2 above were in conformance with regulations and rules therefore as required in the current manual of survey instructions of the United States Department of the Interior, Bureau of Land Management or by a decree of a Court of Law and for that the corner points mentioned in lines 3, 4 and 5 above were in conformance with the rules of the Michigan Board of Land Surveyors or by a Decree of a Court of Law; established, re-established, monumented, recovered, found as expressed below:

NOTE: Not more than 2 corners, all in the same town and range, may be recorded on this certificate.

1	A	B	C	D	E	F	G	H	I	J	K	L	M
2	6		5			4		3		2		1	
3													
4	7		8		9		10		11		12		
5													
6	18		17		16		15		14		13		
7													
8	19		20		21		22		23		24		
9													
10	30		29		28		27		26		25		
11													
12	31		32		33		34		35		36		
13													


A. Description of original monument and accessories and/or subsequent restoration:

G-3  
1855 George Cannon (Resurvey)  
Set wood post and 2 witnesses  
1951 Asa Ennes  
1" bar 4 witnesses  
Jan 24, 1975 Delmer Porter #15410  
found 1" bar and 3 witnesses

Sept. 12, 1977 Delmer Porter #15410  
found 1" bar and 3 witnesses  
July 29, 1981 Delmer Porter #15410  
1" bar and 3 witnesses  
Dec 13, 1988 Clifford Lindgren #14098  
found 1" bar replaced with 1/2" rod  
and cap #14098 set 4 witnesses

B. Description of corner evidence found and/or method applied in restoring or reestablishing corner:


G-3  
Found 1/2" rod and cap #14098 in mon box  
Replaced with 5/8" rod and remon cap

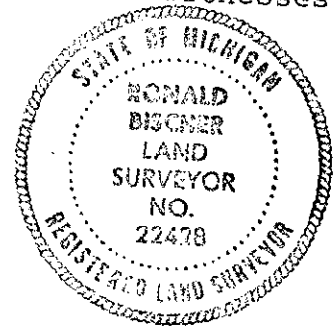

C. Description of monument for corner and accessories established to perpetuate locating the position of the corner:

G-3  
5/8" Rod and remon cap  
N35°E 89.15' 9" W. Birch O.W.  
N34°W 92.70' 12" R. Pine  
S30°W 51.83' T. Pole O.W.  
S10°E 63.58' R/W Marker O.W.

LIBER 011 PAGE 106

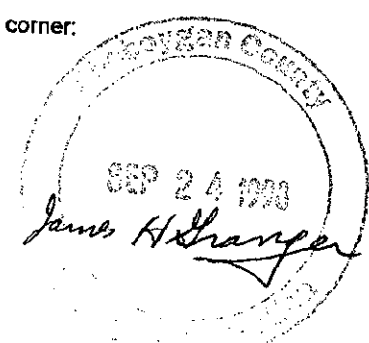

Signed by Ronald R. Bischer  
Surveyor's Michigan License No. 22428

Date Sept. 28, 1998