

LAND CORNER RECORDATION CERTIFICATE
Filing Requirement of Act 74, Mich. P.A. 1970

1998

For corners in

Cheboygan Located In: Corner Code #
(County)
Forest Township
1. Public Land Survey T34N R 1E T-2
T___ R___
T___ R___
T___ R___
2. Property Controlling S___ T___ R___
in Section S___ T___ R___
3. Miscellaneous S___ T___ R___
Property in Sec. S___ T___ R___

SECTION
RECEIVED FOR RECORD 12-7-98
at 9:43 O'Clock A. M
Joanne Spray
CLERK/REGISTER
CHEBOYGAN COUNTY, MICHIGAN
Register of Deeds Stamp & File Number

4. Lot No. _____, Recorded Plat _____
5. Private Claims _____

I, Ronald Bischer, in a field survey on 7-22, 19 98 do hereby state that under requirements of P.A. 74, Michigan P.A. of 1970, the corner points mentioned in lines 1 and 2 above were in conformance with regulations and rules therefore as required in the current manual of survey instructions of the United States Department of the Interior, Bureau of Land Management or by a decree of a Court of Law and /or that the corner points mentioned in lines 3, 4 and 5 above were in conformance with the rules of the Michigan Board of Land Surveyors or by a Decree of a Court of Law; established, re-established, monumented, recovered, found as expressed below.

A	B	C	D	E	F	G	H	I	J	K	L	M
1												
2	6	5	4	3	2	1						
3												
4	7	8	9	10	11	12						
5												
6	18	17	16	15	14	13						
7												
8	19	20	21	22	23	24						
9												
10	30	29	28	27	26	25						
11												
12	31	32	33	34	35	36						
13												

NOTE: Not more than 2 corners, all in the same town and range, may be recorded on this certificate.

A. Description of original monument and accessories and/or subsequent restoration:

I-2
1855 George Cannon (Resurvey)
set wood post and 2 witnesses
Nov. 20, 1922 David Bowen
set 4" sq. post and 1 1/2" gas pipe
1 witness
Aug 1952 Orlando Doyle #7319
Found 1 1/2" pipe 3 witnesses

March 22, 1975 Delmer Porter #15410
2" gas pipe and raised with 1/2" rod
and cap #15410 3 witnesses
July 7, 1994 Norman Quaine #33984
found 1/2" rod and cap and set 4 witnesses


B. Description of corner evidence found and/or method applied in restoring or reestablishing corner:

I-2
Found 1/2" rod and cap and 4 witnesses
replaced with 5/8" rod and remon cap



C. Description of monument for corner and accessories established to perpetuate locating the position of the corner:

I-2
5/8" rod and remon cap
S80°E 25.49' P. Pole O.W.
N52°W 45.95' 7" W. pine O.W.
S40°W 76.93' 11" Aspen O.W.
S30°E 39.68' 8" W. Pine O.W.

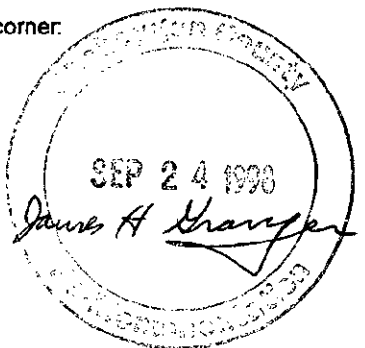

LIBER 011 PAGE 108

Signed by Ronald R. Bischer
Surveyor's Michigan License No. 22428

Date Sept. 28, 1998