

1998 CHEBOYGAN COUNTY, STATE OF MICHIGAN REMONUMENTATION

RECORDATION SECTION

SEP 22 1998

LAND CORNER RECORDATION CERTIFICATE  
Filing Requirement of Act 74, Mich. P.A. 1970

SECTION

For corners in

Cheboygan  
(County)  
Forest Township  
1. Public Land Survey

Located In:	Corner Code #
T 34 R 1 E	I-3
T R	
T R	
T R	
T R	
S T R	
S T R	
S T R	
S T R	

2. Property Controlling in Section  
3. Miscellaneous Property in Sec.

RECEIVED FOR RECORD 12-7-98  
at 9:44 O'Clock A. M

*Joanne Spray*

CLERK/REGISTER  
CHEBOYGAN COUNTY, MICHIGAN

Register of Deeds Stamp & File Number

4. Lot No. \_\_\_\_\_, Recorded Plat \_\_\_\_\_  
5. Private Claims \_\_\_\_\_

I, Ronald Bischer, in a field survey on 7-23, 1998 do hereby state that under requirements of P.A. 74, Michigan P.A. of 1970, the corner points mentioned in lines 1 and 2 above were in conformance with regulations and rules therefore as required in the current manual of survey instructions of the United States Department of the Interior, Bureau of Land Management or by a decree of a Court of Law and for that the corner points mentioned in lines 3, 4 and 5 above were in conformance with the rules of the Michigan Board of Land Surveyors or by a Decree of a Court of Law; established, re-established, monumented, recovered, found as expressed below:

NOTE: Not more than 2 corners, all in the same town and range, may be recorded on this certificate.

	A	B	C	D	E	F	G	H	I	J	K	L	M
1													
2	6		5		4		3		2		1		
3													
4	7		8		9		10		11		12		
5													
6	18		17		16		15		14		13		
7													
8	19		20		21		22		23		24		
9													
10	30		29		28		27		26		25		
11													
12	31		32		33		34		35		36		
13													

A. Description of original monument and accessories and/or subsequent restoration:

I-3  
1855 George Cannon (Resurvey)  
set wood post and 2 witnesses  
Nov. 20, 1922 David Bowen  
set 1 1/2" pipe in rd. intersection  
1948 Asa Ennes Found 1 1/2" pipe  
set 3 witnesses  
Dec 12, 1977 Ronald Bischer #22428  
found 3/4" iron bar, left 3 witnesses

Dec. 12, 1988 Clifford Lindgren #1409  
found 3/4" iron in mon. box  
left 4 witnesses  
July 5, 1994 Norman Quaine #33984  
3/4" bar and 4 witnesses  
Jan 6, 1997 Norman Quaine #33984  
3/4" Bar and 4 witnesses

B. Description of corner evidence found and/or method applied in restoring or reestablishing corner:

I-3  
Found 3/4" bar  
replaced with 5/8" rod and remon cap




C. Description of monument for corner and accessories established to perpetuate locating the position of the corner:

I-3  
5/8" rod and remon cap

S05°W	36.98'	6" Balsam	O.W.
S67°W	36.58'	P. Pole	O.W.
N59°E	44.38'	4x4 conc mon	O.W.
N08°W	113.05'	P. Pole	O.W.

LIBER 011 PAGE 109

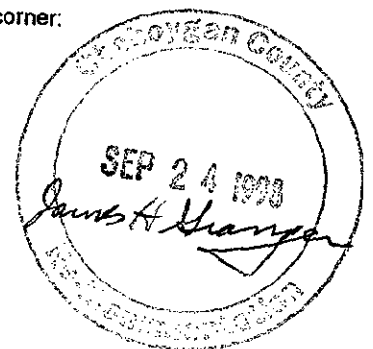

Signed by Ronald R. Bischer  
Surveyor's Michigan License No. 22428

Date Sept. 28, 1998