

RECEIVED FOR RECORD

99 DEC 27 PM 4: 19

LAND CORNER RECORDATION CERTIFICATE
Filing Requirement of Act 74, Mich. P.A. 1970

Ronald Bischer
CLERK/REGISTER
CHEBOYGAN COUNTY MICHIGAN

MAR 03 2000

MAR 03 2000

SECTION

Register of Deeds Stamp & File Number

For corners in

CHEBOYGAN (County)	Located In:	Corner Code #
1. Public Land Survey	T ³⁴ N R 1 E	I-5
	T R	
	T R	
	T R	
2. Property Controlling in Section	S T R	
	S T R	
3. Miscellaneous Property in Sec.	S T R	
	S T R	

4. Lot No. _____, Recorded Plat _____
5. Private Claims _____

	A	B	C	D	E	F	G	H	I	J	K	L
1												
2	6		5		4		3		2		1	
3												
4	7		8		9		10		11		12	
5												
6	18		17		16		15		14		13	
7												
8	19		20		21		22		23		24	
9												
10	30		29		28		27		26		25	
11												
12	31		32		33		34		35		36	
13												

I, Ronald Bischer, in a field survey on Aug. 10, 1999 do hereby state that under requirements of P.A. 74, Michigan P.A. of 1970, the corner points mentioned in lines 1 and 2 above were in conformance with regulations and rules therefore as required in the current manual of survey instructions of the United States Department of the Interior, Bureau of Land Management or by a decree of a Court of Law and/or that the corner points mentioned in lines 3, 4 and 5 above were in conformance with the rules of the Michigan Board of Land Surveyors or by a Decree of a Court of Law; established, re-established, monumented, recovered, found as expressed below:

NOTE: Not more than 2 corners, all in the same town and range, may be recorded on this certificate.

A. Description of original monument and accessories and/or subsequent restoration:

I-5
1855 GLO Notes Resurvey
S47°W 11 lks 7" Spruce
N87°E 25 lks 7" Spruce

Oct. 9, 1975 Delmer Porter #15410 found old stake point & cedar stake set 1/2" rod and cap
N82°E 6.91' 12" Cedar
S59°E 7.70' 12" Cedar
S26°W 12.95' 8" Spruce

B. Description of corner evidence found and/or method applied in restoring or reestablishing corner:


I-5
Aug. 10, 1999 Cheboygan County Remonumentation
Ronald Bischer #22428
found 1/2" rod and cap replaced with 5/8" rod and cap #22428
found all three old witnesses set 1 new one



C. Description of monument for corner and accessories established to perpetuate locating the position of the corner:

I-5
5/8" rod and cap #22428
N82°E 6.91' 13" Cedar
S54°E 7.70' 12' Cedar
S30°W 12.95' 10" Spruce
N79°W 13.97' 6" Cedar

LIBER 011 PAGE 174

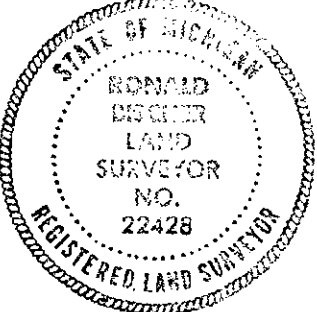

Signed by Ronald R. Bischer
Surveyor's Michigan License No. 22428

Date 12-18-99