

RECEIVED  
FOR RECORD

99 DEC 27 PM 3:45

LAND CORNER RECORDATION CERTIFICATE  
Filing Requirement of Act 74, Mich. P.A. 1970

For corners in

Cheboygan Located in: Corner Code #  
(County)

- 1. Public Land Survey T 34 R 1E J-1  
T 35 R 1E J-13  
T \_\_\_\_\_ R \_\_\_\_\_  
T \_\_\_\_\_ R \_\_\_\_\_
- 2. Property Controlling in Section S \_\_\_\_\_ T \_\_\_\_\_ R \_\_\_\_\_  
S \_\_\_\_\_ T \_\_\_\_\_ R \_\_\_\_\_
- 3. Miscellaneous Property in Sec. S \_\_\_\_\_ T \_\_\_\_\_ R \_\_\_\_\_  
S \_\_\_\_\_ T \_\_\_\_\_ R \_\_\_\_\_

- 4. Lot No. \_\_\_\_\_, Recorded Plat \_\_\_\_\_
- 5. Private Claims \_\_\_\_\_

I, Ronald Bischer, in a field survey on Aug. 10, 1999 do hereby state that under requirements of P.A. 74, Michigan P.A. of 1970, the corner points mentioned in lines 1 and 2 above were in conformance with regulations and rules therefore as required in the current manual of survey instructions of the United States Department of the Interior, Bureau of Land Management or by a decree of a Court of Law and /or that the corner points mentioned in lines 3, 4 and 5 above were in conformance with the rules of the Michigan Board of Land Surveyors or by a Decree of a Court of Law; established, re-established, monumented, recovered, found as expressed below:

NOTE: Not more than 2 corners, all in the same town and range, may be recorded on this certificate.


A. Description of original monument and accessories and/or subsequent restoration:

J-1  
1840 GLO Notes  
N17°W 12 lks 24" Sugar  
N51°E 31 lks 12" Sugar  
Nov. 20, 1922 David Bowen  
4" Sq. cedar post with light T-rail  
driven along side of post on stone ridge

Dec. 20, 1993 Ronald Bischer #2242  
set 1/2" rod @ very old fence corner  
S13°W 21.60' 9" Maple  
N22°W 32.98' 6" Ironwood  
N27°E 68.85' 18" Cedar  
N31°E 32.36' 7" Maple  
July 5, 1994 Norman Quaine #33984  
1/2" rod and cap and 4 witnesses

B. Description of corner evidence found and/or method applied in restoring or reestablishing corner:


J-1  
Aug. 10, 1999 Cheboygan County Remonumentation  
Ronald Bischer #22428  
found 1/2" rod and cap  
replaced with 5/8" rod and cap  
found 4 witnesses

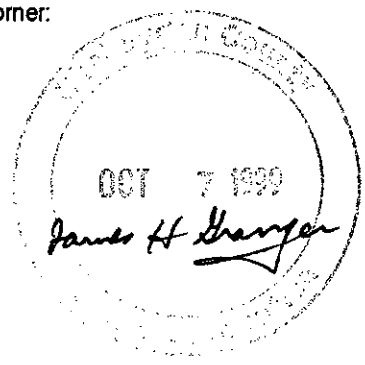

C. Description of monument for corner and accessories established to perpetuate locating the position of the corner:

J-1  
5/8" bar and cap #22428  
N32°E 68.90' 18" Cedar  
N16°W 32.93' 10" Ironwood  
N82°E 6.44' 6" Elm  
S19°W 21.65' 12" Maple

LIBER 011 PAGE 159

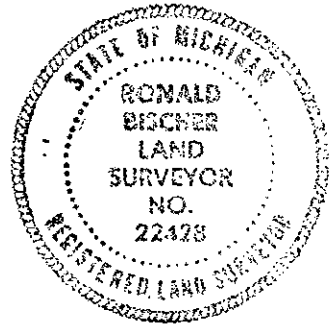

Signed by Ronald R. Bischer  
Surveyor's Michigan License No. 22428

Date 12-18-99

|    |    |   |    |   |    |   |    |   |    |   |    |   |
|----|----|---|----|---|----|---|----|---|----|---|----|---|
|    | A  | B | C  | D | E  | F | G  | H | I  | J | K  | L |
| 1  |    |   |    |   |    |   |    |   |    |   |    |   |
| 2  | 6  |   | 5  |   | 4  |   | 3  |   | 2  |   | 1  |   |
| 3  |    |   |    |   |    |   |    |   |    |   |    |   |
| 4  | 7  |   | 8  |   | 9  |   | 10 |   | 11 |   | 12 |   |
| 5  |    |   |    |   |    |   |    |   |    |   |    |   |
| 6  | 18 |   | 17 |   | 16 |   | 15 |   | 14 |   | 13 |   |
| 7  |    |   |    |   |    |   |    |   |    |   |    |   |
| 8  | 19 |   | 20 |   | 21 |   | 22 |   | 23 |   | 24 |   |
| 9  |    |   |    |   |    |   |    |   |    |   |    |   |
| 10 | 30 |   | 29 |   | 28 |   | 27 |   | 26 |   | 25 |   |
| 11 |    |   |    |   |    |   |    |   |    |   |    |   |
| 12 | 31 |   | 32 |   | 33 |   | 34 |   | 35 |   | 36 |   |
| 13 |    |   |    |   |    |   |    |   |    |   |    |   |