

RECEIVED FOR RECORD

99 DEC 27 PM 3:48

1999 CHEBOYGAN COUNTY REMONUMENTATION

LAND CORNER RECORDATION CERTIFICATE  
Filing Requirement of Act 74, Mich. P.A. 1970

For corners in

<u>Cheboygan</u> (County)	Located In:	Corner Code #
1. Public Land Survey	T34N R 1E	J-3
	T R	
	T R	
	T R	
2. Property Controlling in Section	S T R	
	S T R	
3. Miscellaneous Property in Sec.	S T R	
	S T R	

CLERK/REGISTER  
CHEBOYGAN COUNTY MICHIGAN

MAR 03 2000

SECTION

Register of Deeds Stamp & File Number

4. Lot No. \_\_\_\_\_, Recorded Plat \_\_\_\_\_  
5. Private Claims \_\_\_\_\_

I, Ronald Bischer, in a field survey on Aug. 10, 1999 do hereby state that under requirements of P.A. 74, Michigan P.A. of 1970, the corner points mentioned in lines 1 and 2 above were in conformance with regulations and rules therefore as required in the current manual of survey instructions of the United States Department of the Interior, Bureau of Land Management or by a decree of a Court of Law and/or that the corner points mentioned in lines 3, 4 and 5 above were in conformance with the rules of the Michigan Board of Land Surveyors or by a Decree of a Court of Law; established, re-established, monumented, recovered, found as expressed below:

A	B	C	D	E	F	G	H	I	J	K	L	M
1												
2	6	5	4	3					2	1		
3									●			
4	7	8	9	10	11	12						
5												
6	18	17	16	15	14	13						
7												
8	19	20	21	22	23	24						
9												
10	30	29	28	27	26	25						
11												
12	31	32	33	34	35	36						
13												

NOTE: Not more than 2 corners, all in the same town and range, may be recorded on this certificate.

A. Description of original monument and accessories and/or subsequent restoration:

J-3  
1855 GLO Notes Resurvey  
N50°W 22 lks 8" Cedar  
S40°E 35½ lks 9" W. Birch  
Nov. 20, 1922 David Bowen  
4" sq. cedar post 22 lks south of road centerline set from OBT Birch  
Aug. 8, 1972 Delmer Porter #15410 set ½" rod and cap #15410  
2' north of centerline

Sept. 21, 1972 Delmer Porter #15410  
½" rod and cap #15410  
S05°W 65.50' Sign post  
N05°W 59.30' P. Pole  
Nov. 28, 1988 Clifford Lindgren #14098  
Set ½" rod and cap #14098 in mon box set 4 witnesses  
July 5, 1994 Norman Quaine #33984

B. Description of corner evidence found and/or method applied in restoring or reestablishing corner:



J-3  
Aug 10, 1999 Cheboygan County Remonumentaiton  
Ronald Bischer #22428  
found ½" rod placed remon cap #22428 on top found 4 witnesses

½" rod and cap #14098 in mon box  
N04°E 59.27' P. Pole  
N28°W 93.95' 10" Norway  
S14°W 76.52' P. Pole  
S18°E 58.02' 8" Aspen

LIBER 011 PAGE 162

C. Description of monument for corner and accessories established to perpetuate locating the position of the corner:

J-3  
½" rod and remon cap #22428  
N01°E 59.27' P. Pole  
N28°W 93.95' 7" Norway  
S14°W 76.52' P. Pole  
S11°E 58.02' 8" Aspen

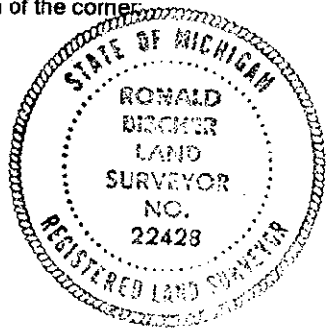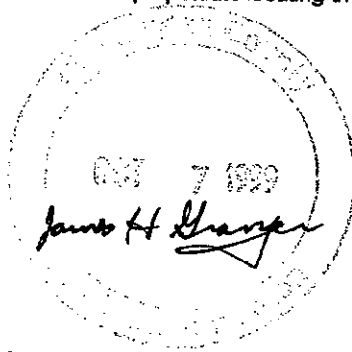

Signed by Ronald E. Bischer

Date 12-18-99

Surveyor's Michigan License No. 22428