

1999 CHEBOYGAN COUNTY REMONUMENTATION

RECEIVED FOR RECORD

99 DEC 27 PM 4:18

LAND CORNER RECORDATION CERTIFICATE
Filing Requirement of Act 74, Mich. P.A. 1970


Udily Popynski
CLERK/REGISTER
CHEBOYGAN COUNTY MICHIGAN

For corners in

CHEBOYGAN (County)	Located in:	Corner Code #
1. Public Land Survey	T <u>34</u> N <u>R 1 E</u>	<u>J-5</u>
	T <u> </u> R <u> </u>	<u> </u>
	T <u> </u> R <u> </u>	<u> </u>
	T <u> </u> R <u> </u>	<u> </u>
2. Property Controlling in Section	S <u> </u> T <u> </u> R <u> </u>	<u> </u>
	S <u> </u> T <u> </u> R <u> </u>	<u> </u>
3. Miscellaneous Property in Sec.	S <u> </u> T <u> </u> R <u> </u>	<u> </u>

MAR 03 2000
SECTION
Register of Deeds Stamp & File Number

4. Lot No. _____, Recorded Plat _____
5. Private Claims _____

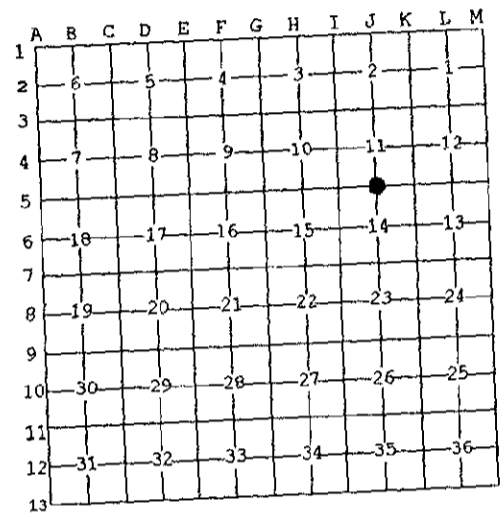

I, Ronald Bischer, in a field survey on Aug. 10, 1999 do hereby state that under requirements of P.A. 74, Michigan P.A. of 1970, the corner points mentioned in lines 1 and 2 above were in conformance with regulations and rules therefore as required in the current manual of survey instructions of the United States Department of the Interior, Bureau of Land Management or by a decree of a Court of Law and/or that the corner points mentioned in lines 3, 4 and 5 above were in conformance with the rules of the Michigan Board of Land Surveyors or by a Decree of a Court of Law; established, re-established, monumented, recovered, found as expressed below:

NOTE: Not more than 2 corners, all in the same town and range, may be recorded on this certificate.

A. Description of original monument and accessories and/or subsequent restoration:

J-5
1855 GLO Notes Resurvey
N08°W 36 lks 7" W. Pine
S21°W 22½ lks 6" W. Pine

Dec. 22, 1976 Ronald Bischer #22428
found 1" sq. axle shaft
N13°E 34.51' 6" Iron wood
N71°W 24.80' 10" Apple

Dec. 8, 1977 Delmer Porter #15410
1" Sq. Axle shaft
N13°E 34.51' 6" Ironwood
N71°W 24.80' 10" Apple
North 11' fence
East 100' fence corner

B. Description of corner evidence found and/or method applied in restoring or reestablishing corner:

J-5
Aug. 10, 1999 Cheboygan County Remonumentation


Ronald Bischer #22428
found 1" Axle shaft replaced with 5/8" rod and cap #22428
found 2 old witnesses
set 2 new witnesses



C. Description of monument for corner and accessories established to perpetuate locating the position of the corner:

J-5
5/8" rod and cap #22428
S54°E 43.55' 10" W. Pine
N16°E 34.51' 9" Ironwood
West 0.64' fence corner
N67°E 38.33' 10" Maple

LIBER 011 PAGE 173

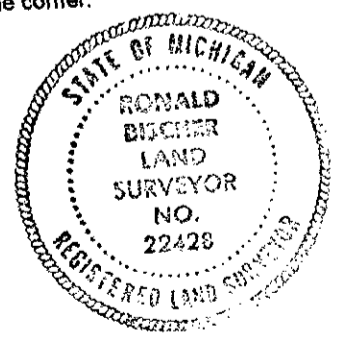

Signed by Ronald R. Bischer
Surveyor's Michigan License No. 22428

Date 12-18-99