

1998 CHEBOYGAN COUNTY, STATE OF MICHIGAN REMONUMENTATION

CHEBOYGAN COUNTY
REGISTERED SURVEYOR

1998

LAND CORNER RECORDATION CERTIFICATE
Filing Requirement of Act 74, Mich. P.A. 1970

SECTION _____

For corners in

Cheboygan Located In: _____ Corner Code # _____
(County)
Forest Township
1. Public Land Survey T34N R1E K-1
Waverly Township T35N R1E K-13
T _____ R _____
T _____ R _____
T _____ R _____
2. Property Controlling S _____ T _____ R _____
in Section S _____ T _____ R _____
3. Miscellaneous S _____ T _____ R _____
Property in Sec. S _____ T _____ R _____

RECEIVED FOR RECORD 12-7-98
at 9:45 O'Clock A. M

Joanne Spray

CLERK/REGISTER
CHEBOYGAN COUNTY, MICHIGAN

Register of Deeds Stamp & File Number

4. Lot No. _____, Recorded Plat _____
5. Private Claims _____

I, Ronald Bischer, in a field survey on 7-22, 1998 do hereby state that under requirements of P.A. 74, Michigan P.A. of 1970, the corner points mentioned in lines 1 and 2 above were in conformance with regulations and rules therefore as required in the current manual of survey instructions of the United States Department of the Interior, Bureau of Land Management or by a decree of a Court of Law and /or that the corner points mentioned in lines 3, 4 and 5 above were in conformance with the rules of the Michigan Board of Land Surveyors or by a Decree of a Court of Law; established, re-established, monumented, recovered, found as expressed below:

NOTE: Not more than 2 corners, all in the same town and range, may be recorded on this certificate.

| | | | | | | | | | | | | | |
|----|----|---|----|---|----|---|----|---|----|---|----|---|---|
| | A | B | C | D | E | F | G | H | I | J | K | L | M |
| 1 | | | | | | | | | | | | | |
| 2 | 6 | | 5 | | 4 | | 3 | | 2 | | 1 | | |
| 3 | | | | | | | | | | | | | |
| 4 | 7 | | 8 | | 9 | | 10 | | 11 | | 12 | | |
| 5 | | | | | | | | | | | | | |
| 6 | 18 | | 17 | | 16 | | 15 | | 14 | | 13 | | |
| 7 | | | | | | | | | | | | | |
| 8 | 19 | | 20 | | 21 | | 22 | | 23 | | 24 | | |
| 9 | | | | | | | | | | | | | |
| 10 | 30 | | 29 | | 28 | | 27 | | 26 | | 25 | | |
| 11 | | | | | | | | | | | | | |
| 12 | 31 | | 32 | | 33 | | 34 | | 35 | | 36 | | |
| 13 | | | | | | | | | | | | | |


A. Description of original monument and accessories and/or subsequent restoration:

K-1
1840 John Hodgson
1855 George Cannon (Resurvey)
set wood post and 4 witnesses
Oct. 4, 1909 David Bowen
4" Sq. cedar post
April 26, 1976 Ronald Bischer #22428
Found Cabin Spike
Set 2 witnesses

June 25, 1976 Delmer Porter #15410
Found cabin spike and 2 witnesses
July 5, 1994 Norman Quaine #33984
found cabin spike and 4 witnesses


B. Description of corner evidence found and/or method applied in restoring or reestablishing corner:

K-1
Found cabin spike
replaced with 5/8" rod and remon cap

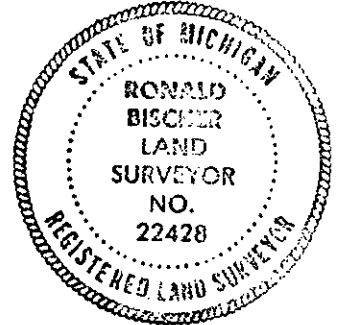

C. Description of monument for corner and accessories established to perpetuate locating the position of the corner:

K-1
5/8" Rod and remon cap
N81°W 50.25' P. Pole O.W.
N75°E 74.55' P. Pole O.W.
N50°E 90.30' 7" Apple O.W.
S50°W 85.66' Fence post O.W.

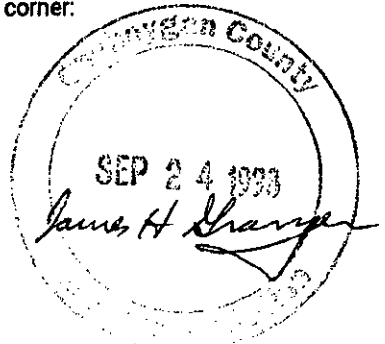

LIBER 011 PAGE 110

Signed by Ronald R. Bischer
Surveyor's Michigan License No. 22428

Date Sept. 28, 1998