

1998 CHEBOYGAN COUNTY, STATE OF MICHIGAN REMONUMENTATION

CHEBOYGAN COUNTY
REMONUMENTATION

SEP 1998

LAND CORNER RECORDATION CERTIFICATE
Filing Requirement of Act 74, Mich. P.A. 1970

SECTION

For corners in

Cheboygan
(County)
Forest Township
1. Public Land Survey

2. Property Controlling
in Section
3. Miscellaneous
Property in Sec.

Located In:	Corner Code #
T <u>34</u> R <u>1E</u>	<u>K-2</u>
T <u> </u> R <u> </u>	<u> </u>
T <u> </u> R <u> </u>	<u> </u>
T <u> </u> R <u> </u>	<u> </u>
S <u> </u> T <u> </u> R <u> </u>	<u> </u>
S <u> </u> T <u> </u> R <u> </u>	<u> </u>
S <u> </u> T <u> </u> R <u> </u>	<u> </u>
S <u> </u> T <u> </u> R <u> </u>	<u> </u>

RECEIVED FOR RECORD 12-7-98
at 9:46 O'Clock A M

Joanne Spray

CLERK/REGISTER
CHEBOYGAN COUNTY, MICHIGAN
Register of Deeds Stamp & File Number

4. Lot No. _____, Recorded Plat _____
5. Private Claims _____

	A	B	C	D	E	F	G	H	I	J	K	L	M
1													
2	6	5	4	3	2	1							
3													
4	7	8	9	10	11	12							
5													
6	18	17	16	15	14	13							
7													
8	19	20	21	22	23	24							
9													
10	30	29	28	27	26	25							
11													
12	31	32	33	34	35	36							
13													


I, Ronald Bischer, in a field survey on 7-23, 1998 do hereby state that under requirements of P.A. 74, Michigan P.A. of 1970, the corner points mentioned in lines 1 and 2 above were in conformance with regulations and rules therefore as required in the current manual of survey instructions of the United States Department of the Interior, Bureau of Land Management or by a decree of a Court of Law and /or that the corner points mentioned in lines 3, 4 and 5 above were in conformance with the rules of the Michigan Board of Land Surveyors or by a Decree of a Court of Law; established, re-established, monumented, recovered, found as expressed below:

NOTE: Not more than 2 corners, all in the same town and range, may be recorded on this certificate.

A. Description of original monument and accessories and/or subsequent restoration:

K-2
1855 George Cannon (Resurvey)
Set wood post and 2 witnesses
Oct. 4, 1909 David Bowen
5" Sq. cedar post with crockery, glass
and iron around post
June 29, 1973 Delmer Porter #15410
Found cabin spike in rd centerline
raised with 1/2" rod and cap 3 witnesses

June 25, 1976 Delmer Porter #15410
found 1/2" rod and cap
3 witnesses also found

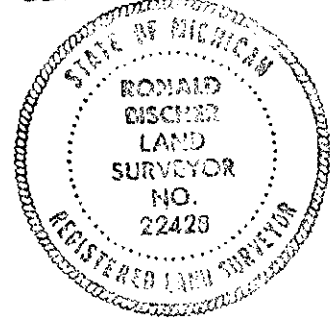

B. Description of corner evidence found and/or method applied in restoring or reestablishing corner:


K-2
found 1/2" rod in centerline
replaced with 5/8" rod and remon cap

C. Description of monument for corner and accessories established to perpetuate locating the position of the corner:

K-2
5/8" rod and remon cap

N87°W 43.05' P. Pole O.W.
S62°W 52.47' Guy Pole O.W.
S75°E 38.74' Guy Pole O.W.
N45°W 52.25' Fence Cor

LIBER 011 PAGE 111

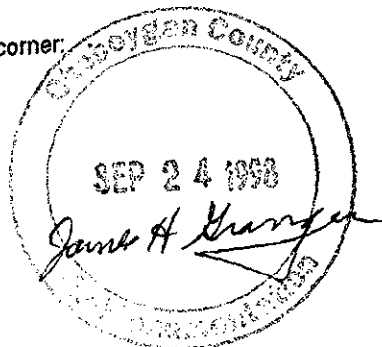

Signed by Ronald R. Bischer
Surveyor's Michigan License No. 22428

Date Sept. 28, 1998