

1998 CHEBOYGAN COUNTY, STATE OF MICHIGAN REMONUMENTATION

1998

LAND CORNER RECORDATION CERTIFICATE
Filing Requirement of Act 74, Mich. P.A. 1970

SECTION

For corners in

Cheboygan
(County)
Forest Township
1. Public Land Survey

Located In:	Corner Code #
T <u>34</u> N R <u>1E</u>	<u>K-3</u>
T <u> </u> R <u> </u>	<u> </u>
T <u> </u> R <u> </u>	<u> </u>
T <u> </u> R <u> </u>	<u> </u>
S <u> </u> T <u> </u> R <u> </u>	<u> </u>
S <u> </u> T <u> </u> R <u> </u>	<u> </u>
S <u> </u> T <u> </u> R <u> </u>	<u> </u>
S <u> </u> T <u> </u> R <u> </u>	<u> </u>

RECEIVED FOR RECORD 12-7-98
at 9:47 O'Clock A M

Joanne Spray

CLERK/REGISTER
CHEBOYGAN COUNTY, MICHIGAN
Register of Deeds Stamp & File Number

4. Lot No. _____, Recorded Plat _____
5. Private Claims _____

Ronald Bischer, in a field survey on 7-23, 19 98 do hereby state that under requirements of P.A. 74, Michigan P.A. of 1970, the corner points mentioned in lines 1 and 2 above were in conformance with regulations and rules therefore as required in the current manual of survey instructions of the United States Department of the Interior, Bureau of Land Management or by a decree of a Court of Law and /or that the corner points mentioned in lines 3, 4 and 5 above were in conformance with the rules of the Michigan Board of Land Surveyors or by a Decree of a Court of Law; established, re-established, monumented, recovered, found as expressed below:

	A	B	C	D	E	F	G	H	I	J	K	L	M
1													
2	6	5	4	3	2	1							
3													
4	7	8	9	10	11	12							
5													
6	18	17	16	15	14	13							
7													
8	19	20	21	22	23	24							
9													
10	30	29	28	27	26	25							
11													
12	31	32	33	34	35	36							
13													

NOTE: Not more than 2 corners, all in the same town and range, may be recorded on this certificate.

A. Description of original monument and accessories and/or subsequent restoration:

K-3
1855 George Cannon (Resurvey)
set wood post and 2 witnesses
Oct. 4, 1909 David Bowen
set 3" Sq. cedar post
1951 Asa Ennes
found 1 1/2" pipe set 4 witnesses
May 16, 1973 Delmer Porter #15410
found 1" rod in mon box 4 witnesses

May 29, 1974 Delmer Porter #15410
found 1" bar in mon box and 4 witness
Dec 13, 1988 Clifford Lindgren #14098
found 1" bar replaced with 1/2" rod and
cap #14098 set 4 witnesses

B. Description of corner evidence found and/or method applied in restoring or reestablishing corner:

K-3
found 1/2" rod and cap in mon box
Replaced with 5/8" rod and remon cap




C. Description of monument for corner and accessories established to perpetuate locating the position of the corner:

K-3
5/8" rod and remon cap

N32°E	71.48'	X in conc marker	O.W.
S40°W	71.98'	X in conc marker	O.W.
N30°W	74.99'	P. Pole	O.W.
S24°E	65.00'	GTE BOX	

LIBER 011 PAGE 112

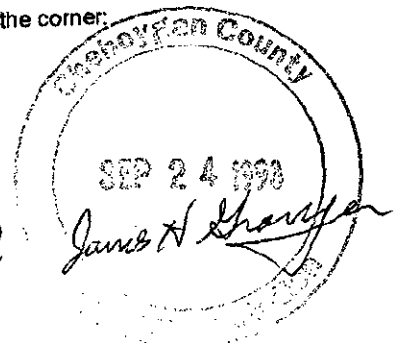

Signed by Ronald R. Bischer
Surveyor's Michigan License No. 22428

Date Sept. 28, 1998