

RECEIVED FOR RECORD

99 DEC 27 PM 4: 13

1999 CHEBOYGAN COUNTY REMONUMENTATION

LAND CORNER RECORDATION CERTIFICATE
Filing Requirement of Act 74, Mich. P.A. 1970

Dilly Pizzagalli

CLERK/REGISTER
CHEBOYGAN COUNTY MICHIGAN

RF

MAR 03 2000

SECTION
Register of Deeds Stamp & File Number

For corners in

Cheboygan
(County)

Located In:

Corner Code #

1. Public Land Survey	T <u>34</u> R <u>1E</u>	<u>K-4</u>
	T <u> </u> R <u> </u>	<u> </u>
	T <u> </u> R <u> </u>	<u> </u>
	T <u> </u> R <u> </u>	<u> </u>
2. Property Controlling in Section	S <u> </u> T <u> </u> R <u> </u>	<u> </u>
	S <u> </u> T <u> </u> R <u> </u>	<u> </u>
3. Miscellaneous Property in Sec.	S <u> </u> T <u> </u> R <u> </u>	<u> </u>
	S <u> </u> T <u> </u> R <u> </u>	<u> </u>

4. Lot No. _____, Recorded Plat _____
5. Private Claims _____

I, Ronald Bischer, in a field survey on Aug. 12, 1999 do hereby state that under requirements of P.A. 74, Michigan P.A. of 1970, the corner points mentioned in lines 1 and 2 above were in conformance with regulations and rules therefore as required in the current manual of survey instructions of the United States Department of the Interior, Bureau of Land Management or by a decree of a Court of Law and/or that the corner points mentioned in lines 3, 4 and 5 above were in conformance with the rules of the Michigan Board of Land Surveyors or by a Decree of a Court of Law; established, re-established, monumented, recovered, found as expressed below:

NOTE: Not more than 2 corners, all in the same town and range, may be recorded on this certificate.

A	B	C	D	E	F	G	H	I	J	K	L
1											
2	6	5	4	3	2	1					
3											
4	7	8	9	10	11	12					
5											
6	10	17	16	15	14	13					
7											
8	19	20	21	22	23	24					
9											
10	30	29	28	27	26	25					
11											
12	31	32	33	34	35	36					
13											

A. Description of original monument and accessories and/or subsequent restoration:


K-4
1855 GLO Notes Resurvey
N50°E 37½ lks 8" Beech
S61°W 4½ lks 12" Beech

April 20, 1988 Ronald Bischer #2242
3/4" pipe in mon box
same witnesses as above

May 29, 1974 Delmer Porter #15410
found 3/4" pipe in mon box
N50°W 38.33' A. Pole
S30°W 48.67' P. Pole S45°E 57.15' A. Pole

B. Description of corner evidence found and/or method applied in restoring or reestablishing corner:

K-4
Aug. 12, 1999 Cheboygan County Remonumentation
Ronald Bischer #22428
Found ½" rod in mon box replace with 5/8" rod and cap #22428
found 3 witnesses

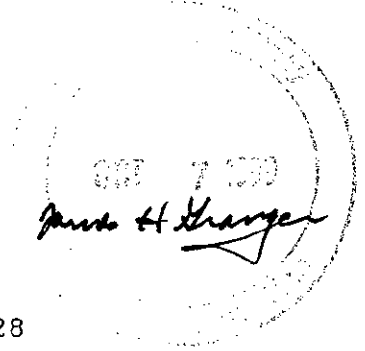

C. Description of monument for corner and accessories established to perpetuate locating the position of the corner:

K-4
5/8" rod and cap #22428
S36°E 57.03' A. Pole
S44°W 48.84' P. Pole
N42°W 37.92' A. Pole
S59°E 35.70' 9" Elm

LIBER 011 PAGE 170



Signed by Ronald R. Bischer
Surveyor's Michigan License No. 22428

Date 12-18-99