

RECEIVED FOR RECORD

99 DEC 27 PM 4: 07

LAND CORNER RECORDATION CERTIFICATE
Filing Requirement of Act 74, Mich. P.A. 1970

Sidley Pyszynski
CLERK/REGISTER
CHEBOYGAN COUNTY MICHIGAN

MAR 03 2000

SECTION

Register of Deeds Stamp & File Number

For corners in

CHEBOYGAN
(County)

Located in:

Corner Code #

- | | | |
|------------------------------------|--------------------------|------------|
| 1. Public Land Survey | T <u>34N</u> R <u>1E</u> | <u>K-5</u> |
| | T ___ R ___ | _____ |
| | T ___ R ___ | _____ |
| | T ___ R ___ | _____ |
| 2. Property Controlling in Section | S ___ T ___ R ___ | _____ |
| | S ___ T ___ R ___ | _____ |
| 3. Miscellaneous Property in Sec. | S ___ T ___ R ___ | _____ |
| | S ___ T ___ R ___ | _____ |

4. Lot No. _____, Recorded Plat _____
5. Private Claims _____

Ronald Bischer, in a field survey on Aug. 12 19 99 do hereby state that under requirements of P.A. 74, Michigan P.A. of 1970, the corner points mentioned in lines 1 and 2 above were in conformance with regulations and rules therefore as required in the current manual of survey instructions of the United States Department of the Interior, Bureau of Land Management or by a decree of a Court of Law and/or that the corner points mentioned in lines 3, 4 and 5 above were in conformance with the rules of the Michigan Board of Land Surveyors or by a Decree of a Court of Law, established, re-established, monumented, recovered, found as expressed below:

NOTE: Not more than 2 corners, all in the same town and range, may be recorded on this certificate.

	A	B	C	D	E	F	G	H	I	J	K	L	M
1													
2	6		5		4		3		2		1		
3													
4	7		8		9		10		11		12		
5													
6	18		17		16		15		14		13		
7													
8	19		20		21		22		23		24		
9													
10	30		29		28		27		26		25		
11													
12	31		32		33		34		35		36		
13													

A. Description of original monument and accessories and/or subsequent restoration:

K-5
1855 GLO Notes Resurvey
N14° E 25 lks 10" W. Pine
S38° W 83 lks 11" W. Pine
Sept. 1949 Orlando Doyle #7319
1" pipe
N83° 30' E 54.44' 12' J. Pine
S07° E 103.14' 12" Y. Pine

May 29, 1974 Delmer Porter #15410
3/4" Pipe in mon box
West 40.25' fence corner
S50° W 89.36' 14" Norway
N85° E 43.74' 6" J. Pine
Dec. 22, 1976 Ronald Bischer #22428
3/4" pipe in mon box
N81° W 39.15' P. Pole
S61° W 72.24' 5" Cedar

B. Description of corner evidence found and/or method applied in restoring or reestablishing corner:


April 11, 1995 Norman Quaine #33984
3/4" Pipe in mon box
N77° W 39.17' P. Pole
S67° W 72.23' 9" Cedar
S88° E 36.36' 5" Balsam
N62° E 52.73' 6" Cedar

Aug. 12, 1999 Cheboygan county remonumentation Ronald Bischer #2242 found all Quaines witnesses found 1/2" rod and 3/4" pipe in mon box replaced with 5/8" rod and cap #2242

Oct. 8, 1996 Norman Quaine #33984 same as above

C. Description of monument for corner and accessories established to perpetuate locating the position of the corner:

K-5
5/8" rod and cap in mon box #22428
N75° W 39.17' P. Pole
S65° W 72.23' 9" Cedar
S87° E 36.36' 5" Balsam
N62° E 52.86' 6" Cedar

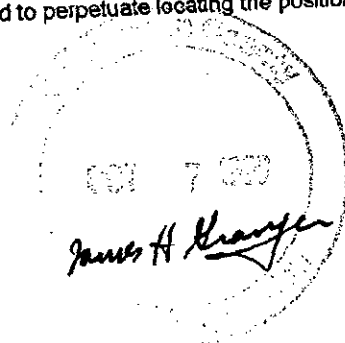

Signed by Ronald R. Bischer
Surveyor's Michigan License No. 22428

Date 12-18-99