

LAND CORNER RECORDATION CERTIFICATE
Filing Requirement of Act 74, Mich. P.A. 1970

99 DEC 27 PM 4: 24

For corners in

<u>Cheboygan</u> (County)	Located in:	Corner Code #
1. Public Land Survey	T <u>34</u> N <u>1</u> E	<u>L-3</u>
	T <u> </u> R <u> </u>	<u> </u>
	T <u> </u> R <u> </u>	<u> </u>
	T <u> </u> R <u> </u>	<u> </u>
2. Property Controlling in Section	S <u> </u> T <u> </u> R <u> </u>	<u> </u>
	S <u> </u> T <u> </u> R <u> </u>	<u> </u>
3. Miscellaneous Property in Sec.	S <u> </u> T <u> </u> R <u> </u>	<u> </u>
	S <u> </u> T <u> </u> R <u> </u>	<u> </u>

Debra Pappas
CLERK/REGISTER
CHEBOYGAN COUNTY MICHIGAN

MAR 03 2000

Register of Deeds Stamp & File Number

4. Lot No. _____, Recorded Plat _____
5. Private Claims _____

	A	B	C	D	E	F	G	H	I	J	K	L
1												
2	6		5		4		3		2		1	
3												
4	7		8		9		10		11		12	
5												
6	18		17		16		15		14		13	
7												
8	19		20		21		22		23		24	
9												
10	30		29		28		27		26		25	
11												
12	31		32		33		34		35		36	
13												

I, Ronald Bischer, in a field survey on Aug. 12, 1999 do hereby state that under requirements of P.A. 74, Michigan P.A. of 1970, the corner points mentioned in lines 1 and 2 above were in conformance with regulations and rules therefore as required in the current manual of survey instructions of the United States Department of the Interior, Bureau of Land Management or by a decree of a Court of Law and /or that the corner points mentioned in lines 3, 4 and 5 above were in conformance with the rules of the Michigan Board of Land Surveyors or by a Decree of a Court of Law; established, re-established, monumented, recovered, found as expressed below:

NOTE: Not more than 2 corners, all in the same town and range, may be recorded on this certificate.


A. Description of original monument and accessories and/or subsequent restoration:

L-3
1855 GLO notes Resurvey
N62°W 45 lks 15" Tamarack
S16°E 12.5' 6" Tamarack
May 29, 1974 Delmer Porter
1/2" bolt in mon box
N25°W 65.98' R/W marker
N45°W 101.18' P. Pole
South 54.00' T. Pole

Nov. 28, 1988 Clifford Lindgren
#14098 1/2" rod and cap in mon box
N35°E 69.99' P. Pole
N15°W 76.12' T. Pole
S65°W 109.88' 4" W. Birch
S05°W 53.96' T. Pole


B. Description of corner evidence found and/or method applied in restoring or reestablishing corner:

L-3
Aug. 12, 1999 Cheboygan County Remonumentation
Ronald Bischer #22428
found 1/2" rod in mon box set remon cap on top
found 4 witnesses

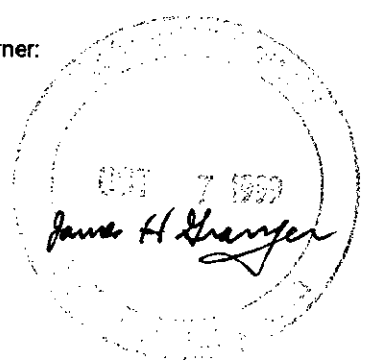

C. Description of monument for corner and accessories established to perpetuate locating the position of the corner:

L-3
1/2" rod and remon cap #22428 in mon box
S08°W 53.96' T. Pole
N11°W 76.05' T. Pole
N37°E 69.99' P. Pole
S65°W 109.88' 5" Birch

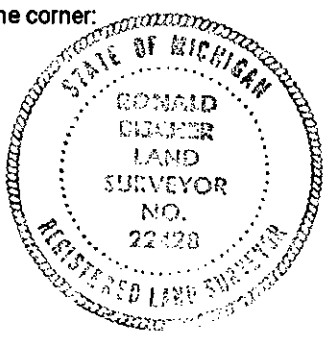

LIBER 011 PAGE 179

Signed by Ronald B. Bischer
Surveyor's Michigan License No. 22428

Date 12-18-99