

✓

MICHIGAN  
DEPARTMENT OF CONSERVATION  
FORESTRY DIVISION

# LAND CORNER RECORD

T. 34 N. R. 1 E


Cheboygan COUNTY

DESCRIPTION OF CORNER 1/4 corner common to Sections 21 and 28

CORNER MONUMENT Set 1" pipe with 4" aluminum cap

DATE MONUMENT PLACED AND WITNESSED December 14, 1965

WITNESSES TO CORNER.....

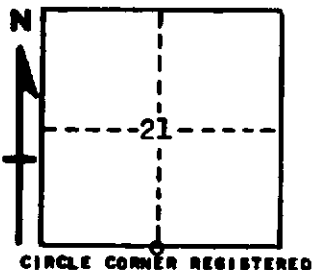

24" White Pine stp S60W 43.2

24" White Pine stp S53E 41.5

AND

DESCRIPTION IN DETAIL AS TO HOW CORNER WAS LOCATED AND IDENTIFIED OR RESTORED.

This corner was set by proportionate measurement, midpoint on line, between section corners. No original evidence left.

SURVEYOR'S SEAL

SIGNED Kenneth J. Ostling DATE December 30, 1965  
REGISTERED LAND SURVEYOR 10068