

**LAND CORNER RECORDATION CERTIFICATE**  
**Filing Requirement of Act 74, Mich. P.A. 1970**

For corners in  
Cheboygan  
(County)

Located In: \_\_\_\_\_ Corner Code ##

- |                                       |   |            |   |           |             |       |
|---------------------------------------|---|------------|---|-----------|-------------|-------|
| 1. Public Land Survey                 | T | <u>34N</u> | R | <u>1E</u> | <u>M-13</u> |       |
|                                       | T | <u>34N</u> | R | <u>1E</u> | <u>L-13</u> |       |
|                                       | T | _____      | R | _____     | _____       |       |
|                                       | T | _____      | R | _____     | _____       |       |
| 2. Property Controlling<br>in Section | S | _____      | T | _____     | R           | _____ |
|                                       | S | _____      | T | _____     | R           | _____ |
| 3. Miscellaneous<br>Property in Sec.  | S | _____      | T | _____     | R           | _____ |
|                                       | S | _____      | T | _____     | R           | _____ |

**Register of Deeds Stamp & File Number**

4. Lot No. \_\_\_\_\_, Recorded Plat \_\_\_\_\_  
 5. Private Claims \_\_\_\_\_

I, Carl R. Johnson, in a field survey on August 25, 19 87, do hereby certify that under requirements of P.A. 74, Michigan P.A. of 1970, the corner points mentioned in lines 1 and 2 above were in conformance with regulations and rules therefore as required in the current manual of survey instructions of the United States Department of the Interior, Bureau of Land Management or by a decree of a Court of Law and/or that the corner points mentioned in lines 3, 4 and 5 above were in conformance with the rules of the Michigan Board of Land Surveyors or by a Decree of a Court of Law, established, re-established, monumented, re-monumented, recovered, found as expressed below:

**NOTE: Not more than 4 corners, all in the same town and range, may be recorded on this certificate.**

	A	B	C	D	E	F	G	H	I	J	K	L	M
2	8		5		4		3		2		1		
3													
4	7		8		9		10		11		12		
5													
6	16		17		16		15		14		13		
7													
8	19		20		21		22		23		24		
9													
10	30		29		28		27		26		25		
11													
12	31		32		33		34		35		36		
13													

A. Description of original monument and accessories and/or subsequent restoration:

B. Description of corner evidence found and/or method applied in restoring or reestablishing corner:

**M-13** - Set by single proportionate measurement between S $\frac{1}{2}$  cor. sec. 36, T34N, R1E and SE corner Sec. 31, T34N, R2E and on extension of fence line on S. side of Section 36. Fits well with stream calls North and East.


**L-13** - Set at extension of fence lines from West and North. Fall at GLO record distance from section corner to west.

C. Description of monument for corner and accessories established to perpetuate locating the position of the corner:

**M-13 - SE Corner**  
 DNR Monument  
 5" Spruce S68°W 35.3'  
 3" Balsam N36°E 2.6'

**L-13 - S $\frac{1}{2}$  Corner**  
 3/4" x 36" pipe w/cap  
 No witnesses available.

Signed by Carl R. Johnson  
 Surveyor's Michigan License No. 30083

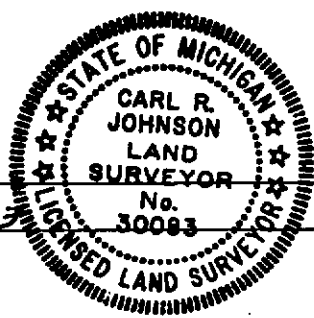

Date 1/4/88