

SURVEY & REMONUMENTATION

CHEBOYGAN COUNTY REMONUMENTATION

MAY 03 1995

LAND CORNER RECORDATION CERTIFICATE
Filing Requirement of Act 74, Mich. P.A. 1970

RECEIVED FOR RECORD

94 NOV 22 AM 10:01

For corners in
Cheboygan

COMMISSION

Located In:

Corner Code #

Joanna Gray
CLERK/REGISTER
CHEBOYGAN COUNTY, MICHIGAN

- | | | |
|------------------------------------|--------------------------|------------|
| 1. Public Land Survey | T <u>34N</u> R <u>1W</u> | <u>A-1</u> |
| | T _____ R _____ | _____ |
| | T _____ R _____ | _____ |
| | T _____ R _____ | _____ |
| 2. Property Controlling in Section | S _____ T _____ R _____ | _____ |
| | S _____ T _____ R _____ | _____ |
| 3. Miscellaneous Property in Sec. | S _____ T _____ R _____ | _____ |
| | S _____ T _____ R _____ | _____ |

Register of Deeds Stamp & File Number

4. Lot No. _____, Recorded Plat _____
5. Private Claims _____

	A	B	C	D	E	F	G	H	I	J	K	L	M
2	6	5	4	3	2	1							
3													
4	7	8	9	10	11	12							
5													
6	18	17	16	15	14	13							
7													
8	19	20	21	22	23	24							
9													
10	30	29	28	27	26	25							
11													
12	31	32	33	34	35	36							
13													

I, James H. Granger, in a field survey on August 15, 19 94, do hereby certify that under requirements of P.A. 74, Michigan P.A. of 1970, the corner points mentioned in lines 1 and 2 above were in conformance with regulations and rules therefore as required in the current manual of survey instructions of the United States Department of the Interior, Bureau of Land Management or by a decree of a Court of Law and/or that the corner points mentioned in lines 3, 4 and 5 above were in conformance with the rules of the Michigan Board of Land Surveyors or by a Decree of a Court of Law; established, re-established, monumented, re-monumented, recovered, found as expressed below:

NOTE: Not more than 4 corners, all in the same town and range, may be recorded on this certificate.


A. Description of original monument and accessories and/or subsequent restoration:

1840 Original Survey set wood post 10" Birch N41°W 9 lks, 10" Beech S45°E 29 lks
John Mullett

B. Description of corner evidence found and/or method applied in restoring or reestablishing corner:

Fd 1" Bolt in Monument Box. Reset 5/8" rebar w/aluminum cap in mon box. Set 4 witnesses.

Marvin A. Fox

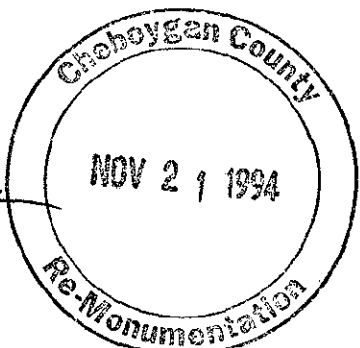


C. Description of monument for corner and accessories established to perpetuate locating the position of the corner:

5/8" rebar w/ aluminum cap in monument box

- | | | |
|---------------|-------|---------|
| Conc Headwall | N29°E | 49.75' |
| Conc Headwall | N19°W | 49.82' |
| 6" Pine | S55°W | 172.86' |
| Fence Post | S04°E | 183.75' |

LIBER **010** PAGE **59**

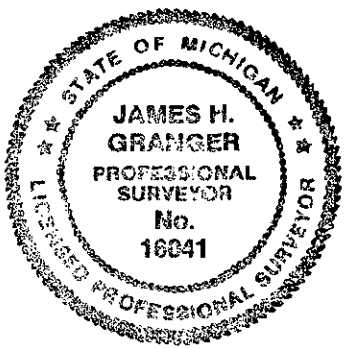

igned by James H. Granger
urveyor's Michigan License No. 16041

Date 11-18-94