

**SURVEY &
REMONUMENTATION**
CHEBOYGAN COUNTY REMONUMENTATION

RECEIVED
FOR RECORD

Walke
MAY 03 1995

LAND CORNER RECORDATION CERTIFICATE
Filing Requirement of Act 74, Mich. P.A. 1970

94 NOV 22 AM 10:00

For corners in

COMMISSION

Cheboygan
(County)

Located In:

Corner Code #

James H. Granger
CLERK/REGISTER
CHEBOYGAN COUNTY, MICHIGAN

- | | | |
|------------------------------------|--------------------------|------------|
| 1. Public Land Survey | T <u>34N</u> R <u>1W</u> | <u>A-2</u> |
| | T _____ R _____ | _____ |
| | T _____ R _____ | _____ |
| | T _____ R _____ | _____ |
| 2. Property Controlling in Section | S _____ T _____ R _____ | _____ |
| | S _____ T _____ R _____ | _____ |
| 3. Miscellaneous Property in Sec. | S _____ T _____ R _____ | _____ |
| | S _____ T _____ R _____ | _____ |

Register of Deeds Stamp & File Number

4. Lot No. _____, Recorded Plat _____
5. Private Claims _____

A	B	C	D	E	F	G	H	I	J	K	L	M
2	6	5	4	3	2	1						
3												
4	7	8	9	10	11	12						
5												
6	18	17	16	15	14	13						
7												
8	19	20	21	22	23	24						
9												
10	30	29	28	27	26	25						
11												
12	31	32	33	34	35	36						
13												

I, James H. Granger, in a field survey on August 15, 19 94, do hereby certify that under requirements of P.A. 74, Michigan P.A. of 1970, the corner points mentioned in lines 1 and 2 above were in conformance with regulations and rules therefore as required in the current manual of survey instructions of the United States Department of the Interior, Bureau of Land Management or by a decree of a Court of Law and/or that the corner points mentioned in lines 3, 4 and 5 above were in conformance with the rules of the Michigan Board of Land Surveyors or by a Decree of a Court of Law; established, re-established, monumented, re-monumented, recovered, found as expressed below:


NOTE: Not more than 4 corners, all in the same town and range, may be recorded on this certificate.

A. Description of original monument and accessories and/or subsequent restoration:

1840 Original Survey Set wood post 10" Sugar N14°W 5 lks, 8" Hemlock S39°E 19 lks John Mullett

B. Description of corner evidence found and/or method applied in restoring or reestablishing corner:

Fd no evidence. Placed 5/8" iron w/ aluminum cap by single proportionate measurement between the NW and SW section corners.

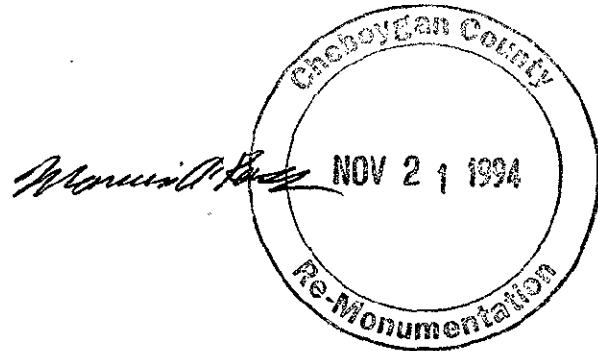


C. Description of monument for corner and accessories established to perpetuate locating the position of the corner:

5/8" rebar w/aluminum cap in Monument Box

- Fence Post N38°W 46.36'
- Fence Post N69°E 50.40'
- Fence Post S58°W 40.14'
- PP S12°E 132.22'

LIBER **010** PAGE **58**

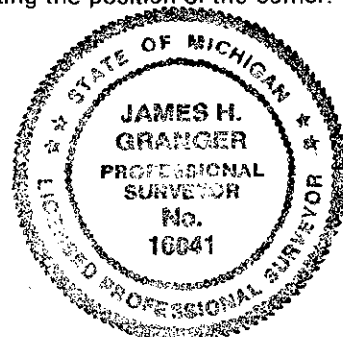

Signed by James H. Granger

Date 11-18-94

Surveyor's Michigan License No. 16041