

SURVEY & REMONUMENTATION

MAX ~~1997~~ 1997

COMMISSION

RE MONUMENTION

LAND CORNER RECORDATION CERTIFICATE
Filing Requirement of Act 74, Mich. P.A. 1970

RECEIVED FOR RECORD

96 NOV 25 PM 1:05

James Gray
CLERK/REGISTER
CHEBOYGAN COUNTY, MICHIGAN

Cheboygan (County) Located In: _____ Corner Code # _____

1. Public Land Survey T 34N R 3W BKF M-5
T R 124190
T R _____
T R _____

2. Property Controlling in Section S T R _____
S T R _____

3. Miscellaneous Property in Sec. S T R _____
S T R _____

Register of Deeds Stamp & File Number

4. Lot No. _____, Recorded Plat _____
5. Private Claims _____

I, Brian K. Fullford, in a field survey on August, 1996 do hereby state that under requirements of P.A. 74, Michigan P.A. of 1970, the corner points mentioned in lines 1 and 2 above were in conformance with regulations and rules therefore as required in the current manual of survey instructions of the United States Department of the Interior, Bureau of Land Management or by a decree of a Court of Law and/or that the corner points mentioned in lines 3, 4 and 5 above were in conformance with the rules of the Michigan Board of Land Surveyors or by a Decree of a Court of Law, established, re-established, monumented, recovered, found as expressed below:

	A	B	C	D	E	F	G	H	I	J	K	L	M
1													
2	6		5		4		3		2		1		
3													
4	7		8		9		10		11		12		
5													
6	18		17		16		15		14		13		
7													
8	19		20		21		22		23		24		
9													
10	30		29		28		27		26		25		
11													
12	31		32		33		34		35		36		
13													

NOTE: Not more than 2 corners, all in the same town and range, may be recorded on this certificate.

A. Description of original monument and accessories and/or subsequent restoration:

- | | |
|----------------------------|-------------------------------|
| G.L.O. | 1966 D.O.C. Corner Record |
| Set Corner Section Post | Kenneth Ostling #10068 |
| 10" Hemlock N16°E 19 Links | Fnd Wood Stake |
| 7" Hemlock S66°W 8 Links | Set 1" Pipe w/4" Aluminum Cap |
| | 16" Red Pine S28°E 104.5' |
| | 8" Red Pine Stump N10°E 22.9' |

B. Description of corner evidence found and/or method applied in restoring or reestablishing corner:

- Fnd 1" Pipe w/Department of Conservation 4" Brass Cap
- Fnd 36" Red Pine S28°E 104' (Ostling Witness)
- Fnd 8" Red Pine Stump N10°E 22' (Ostling Witness)




LIBER 010 PAGE 207

C. Description of monument for corner and accessories established to perpetuate locating the position of the corner:

- M-5 Fnd 1" Pipe w/Department of Conservation 4" Brass Cap. Accepted as a careful & faithful re-establishment of the position of the original corner.
- 12" Red Pine N10°E 26.63' Set Tag
 - 5" White Pine S86°E 18.63' Set Tag
 - 5" Red Pine S31°W 15.03' Set Tag
 - 10" Aspen N62°W 7.96' Set Tag

Marwan A. Ray

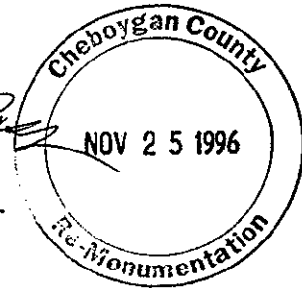

THIS CORNER IS ALSO DESIGNATED AS CORNER CODE #A-5, IN T34N-R1E.

Brian K. Fullford

Signed by _____ 41099
Surveyor's Michigan License No. _____
Brian K. Fullford, PS

Date 10/22/96