

**SURVEY & REMONUMENTATION**

MAY 05 1997

COMMISSION

**RE MONUMENTATION  
LAND CORNER RECORDATION CERTIFICATE**  
Filing Requirement of Act 74, Mich. P.A. 1970

RECEIVED FOR RECORD

96 NOV 25 PM 1:07

*James J. Gray*  
CLERK/REGISTER  
CHEBOYGAN COUNTY, MICHIGAN

For corners in

Cheboygan

(County)

Located In:

Corner Code #

1. Public Land Survey

2. Property Controlling in Section

3. Miscellaneous Property in Sec.

4. Lot No. \_\_\_\_\_, Recorded Plat \_\_\_\_\_

5. Private Claims \_\_\_\_\_

	T	34N	R	1W	M-7
	T		R		
	T		R		
	T		R		
S	T		R		
S	T		R		
S	T		R		
S	T		R		

Register of Deeds Stamp & File Number

A	B	C	D	E	F	G	H	I	J	K	L	M
1												
2	6		5		4		3		2			1
3												
4	7		8		9		10		11			12
5												
6	10		17		16		15		14			13
7												
8	19		20		21		22		23			24
9												
10	30		29		28		27		26			25
11												
12	31		32		33		34		35			36
13												

I, Brian K. Fullford, in a field survey on August, 1996 do hereby state that under requirements of P.A. 74, Michigan P.A. of 1970, the corner points mentioned in lines 1 and 2 above were in conformance with regulations and rules therefore as required in the current manual of survey instructions of the United States Department of the Interior, Bureau of Land Management or by a decree of a Court of Law and/or that the corner points mentioned in lines 3, 4 and 5 above were in conformance with the rules of the Michigan Board of Land Surveyors or by a Decree of a Court of Law; established, re-established, monumented, recovered, found as expressed below:

NOTE: Not more than 2 corners, all in the same town and range, may be recorded on this certificate.

- A. Description of original monument and accessories and/or subsequent restoration:
  - G.L.O. 1951 LCRC
  - Set Corner Section Post Liber A, Page 113
  - 14" Tamarack S32°W 22 Links Dean DeLamater #5778
  - 10" Cedar N27°W 24 Links Fnd Original B.T.
  - Set 1" Pipe w/Dept. Of Conservation 4" Brass Cap
  - 5" Tamarack S12° 74 Links
  - 5" White Birch N34°W 24 Links

- B. Description of corner evidence found and/or method applied in restoring or reestablishing corner:
  - Fnd 1 1/2" Pipe with Concrete Base
  - 5" Tamarack S12°W 48' (Dead-DeLamater Witness)
  - 5" Birch N34°W 15.6 (Dead-DeLamater Witness)
  - Fnd Square Cedar Stake Lying On Ground
  - Measured (hip chain) 2643' to 1/4 Corner North




LIBER 010 PAGE 209

- C. Description of monument for corner and accessories established to perpetuate locating the position of the corner:

M-7 Fnd 1 1/2" Pipe with Concrete Base. Placed 5/8" x 36" Rebar with Remonumentation Cap inside pipe. Accepted as a careful & faithful re-establishment of the position of the original corner.

8" Aspen N53°E 26.08' Set Tag  
6" Balsam N72°E 22.73' Set Tag  
4" Balsam S35°E 5.54' Set Tag  
6" Balsam N02°W 42.52' Set Tag

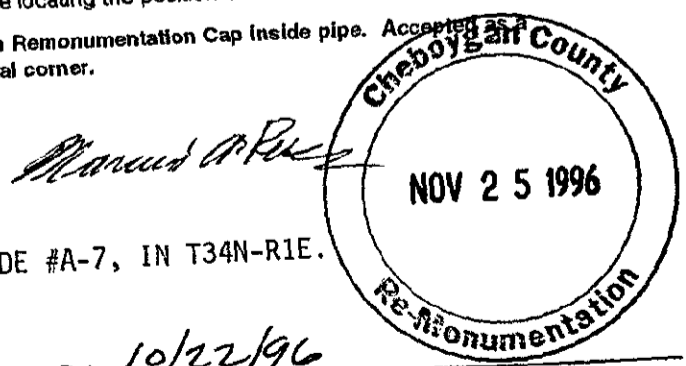

THIS CORNER IS ALSO DESIGNATED AS CORNER CODE #A-7, IN T34N-R1E.

Signed by Brian K. Fullford 41099  
Surveyor's Michigan License No. \_\_\_\_\_  
Brian K. Fullford, PS

Date 10/22/96