

LAND CORNER RECORDATION CERTIFICATE

FILING REQUIREMENT OF ACT 74, MICH. P.A.1970

FOR CORNERS OF--:	LOCATED IN--:	CORNER CODE NUMBER
1. PUBLIC LAND SURVEY_____	T. 34 N. R. 1 W. ●	J-2, K-2
2. PROPERTY CONTROLL- ING IN SECTION 2_____	T. 34 N. R. 1 W. ●	8, 9
3. MISCELLANEOUS PROPERTY IN SECTION_____	T. _____ N. S., R. _____ E. W.	_____
4. LOT NO. _____, RECORDED PLAT _____		
5. PRIVATE CLAIMS _____		

REGISTER OF DEEDS STAMP AND
FILING NUMBER

I, Kenneth J. Ostling, do hereby certify that under requirements of P.A. 74, Michigan P.A. of 1970, the corner points mentioned in lines 1 and 2 above were, in a field survey on December 8, 1976, established, re-established, monumented, re-monumented, recovered or restored as expressed below and in conformance with regulations and rules therefore as required in the current manual of survey instructions of the United States Department of the Interior, Bureau of Land Management or by a decree of a court of law. Furthermore, that the corner points mentioned in lines 3, 4 and 5 above were, in a field survey on _____, 19____, found, recovered, restored, established or re-established as expressed below and in conformance with the rules of the Michigan State Board of Registration for Land Surveyors or, by a Decree of a Court of law:

A. Description of original monument and accessories and/or subsequent restoration:

B. Description of corner evidence found and/or method applied in restoring or re-establishing corner:

- J-2 Set at the calculated intersection of the true $\frac{1}{4}$ lines. No previous corner.
- K-2 This corner set by proportionate measurement during 1966 survey, and used in current survey of Section 2.
- 8 Set by standard survey procedure for the subdivision of sections.
- 9 Set by standard survey procedure for the subdivision of sections.

C. Description of monument for corner and accessories established to perpetuate locating the position of the corner:

J-2	K-2	8
Set 3/8" hex rod & red-top post	Set 1" pipe w/alum. cap	Set 3/8" hex rod & post
3" Ash S40°E 19.25	6" Cedar N38°E 34.9 ('66)	5" Spruce S72°E 14.5
10" Birch N40°E 4.0	9" Cedar S26°W 3.5 ('66)	6" Spruce S23°W 40.0
	9	
	Set 3/8" hex rod & red-top post	
	2" Birch N10°E 8.4	
	16" Spruce N86°W 74.5	


SIGNED BY *Kenneth J. Ostling* DATE 12-15-76

SURVEYOR'S MICHIGAN REGISTRATION NO. 10068

FOR STATE AND UNITED STATES AGENCIES:

SIGNED BY _____ DATE _____
CHIEF OF SURVEY PARTY

APPROVED AND SIGNED BY _____ DATE _____
MICHIGAN REGISTERED LAND SURVEYOR

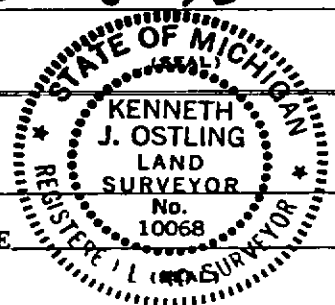

SURVEYOR'S MICHIGAN REGISTRATION NO. _____ CHEBOYGAN COUNTY