

MICHIGAN
DEPARTMENT OF CONSERVATION
FORESTRY DIVISION

LAND CORNER RECORD

T. 34 N.R. 1 W


Cheboygan COUNTY

DESCRIPTION OF CORNER Section corner common to Sections 20-21-28-29

CORNER MONUMENT Set 1" pipe with 4" brass cap

DATE MONUMENT PLACED AND WITNESSED 11/1/62

WITNESSES TO CORNER.....

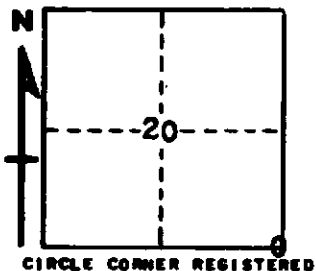

7" Cedar	-	S23E	-	22.8 ft
12" Cedar	-	N44W	-	12.4 ft
AND 13" Cedar	-	S76W	-	25.0 ft

DESCRIPTION IN DETAIL AS TO HOW CORNER WAS LOCATED AND IDENTIFIED OR RESTORED.

This corner was found while making a survey in this area. Found 1 1/2" pipe in place as established by Marcus Schaaf, RLS, in 1940. Sites for possible USBTs in place. Also an old witness SW'ly from corner, scribed at about 6" diameter, and opened up on several occasions. Does not appear to be an original BT, but does lend support to this position for corner.

SURVEYOR'S SEAL

SIGNED *Kenneth J. Oetting* DATE 11/1/62
REGISTERED LAND SURVEYOR