

MICHIGAN
DEPARTMENT OF CONSERVATION
FORESTRY DIVISION

LAND CORNER RECORD


T. 34 N.R. 1 W
T 33 NR 1 W Cheboygan COUNTY

DESCRIPTION OF CORNER 1/4 corner common to Sections 33-4

CORNER MONUMENT Set 1" pipe with 4" A luminum cap

DATE MONUMENT PLACED AND WITNESSED 10/15/62

WITNESSES TO CORNER.....

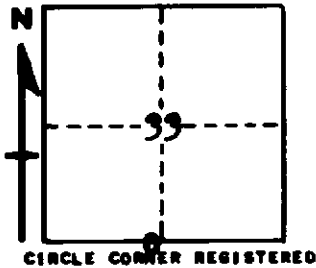

7" H. Maple - N80E - 2.8 ft

14" Hemlock - N75W - 25.7 ft

AND

DESCRIPTION IN DETAIL AS TO HOW CORNER WAS LOCATED AND IDENTIFIED OR RESTORED.

This corner was established while making a survey in this township. Set corner by proportionate measurement, midpoint on line, between section corners. No previous corner could be located. Falls on north edge of fireline.

SURVEYOR'S SEAL

SIGNED *Kenneth J. Ostling* DATE 11/5/62
REGISTERED LAND SURVEYOR