

MICHIGAN
DEPARTMENT OF CONSERVATION
FORESTRY DIVISION

LAND CORNER RECORD

T. 34 N.R. 1 W


Cheboygan COUNTY

DESCRIPTION OF CORNER 1/4 corner common to sections 21-28

CORNER MONUMENT Set 1" pipe with 4" aluminum cap

DATE MONUMENT PLACED AND WITNESSED June 17, 1966

WITNESSES TO CORNER.....

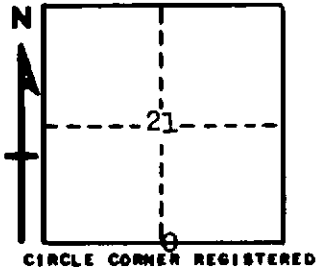

5" S. Maple S 64 W 51.6'

36" W. Pine stump N 57 W 42.0'

AND

DESCRIPTION IN DETAIL AS TO HOW CORNER WAS LOCATED AND IDENTIFIED OR RESTORED.

This corner was set by proportionate measurement between section corners while making a retracement in this township. Nothing left for USBTs or a previous corner.

SURVEYOR'S SEAL

SIGNED *Kenneth A. Osting* DATE June 20, 1966
REGISTERED LAND SURVEYOR #10068