

MICHIGAN
DEPARTMENT OF CONSERVATION
FORESTRY DIVISION

LAND CORNER RECORD

T. 34 N. R. 1 W


Cheboygan COUNTY

DESCRIPTION OF CORNER 1/4 corner common to sections 27-34

CORNER MONUMENT Set 1" pipe with 4" aluminum cap

DATE MONUMENT PLACED AND WITNESSED June 16, 1966

WITNESSES TO CORNER.....

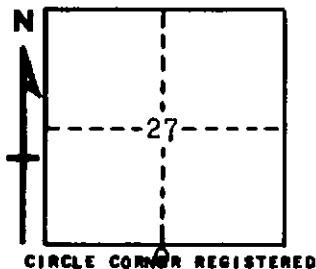

5" R. Pine N 42 E 9.9'

9" W. Pine S 86 W 32.2'

AND

DESCRIPTION IN DETAIL AS TO HOW CORNER WAS LOCATED AND IDENTIFIED OR RESTORED.

This corner was set by proportionate measurement between section corners while making a retracement in this township. Nothing left for USBTs.

SURVEYOR'S SEAL

SIGNED *Kenneth J. Osting* DATE June 20, 1966
REGISTERED LAND SURVEYOR # 10068