

MICHIGAN  
DEPARTMENT OF CONSERVATION  
FORESTRY DIVISION

# LAND CORNER RECORD

T. 34 N.R. 1 W


Cheboygan COUNTY

DESCRIPTION OF CORNER Section corner common to sections 11-12-13-14

CORNER MONUMENT Set 3/4" x 24" iron bar

DATE MONUMENT PLACED AND WITNESSED August 1966

WITNESSES TO CORNER.....

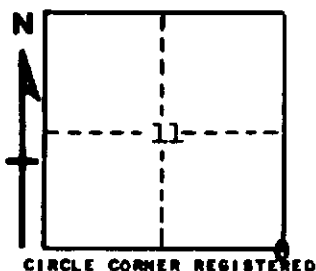

Corner fence post S 80 E 35.4'

Corner fence post S 40 W 45.5'

AND

DESCRIPTION IN DETAIL AS TO HOW CORNER WAS LOCATED AND IDENTIFIED OR RESTORED.

This corner was established while making a survey in this township. Set corner by proportionate measurement for latitude, at double distance from 1/4 and section corner east. This method conforms to occupation north and west, follows very nearly along fence line east, and checks U.S. record to physical features south.

SURVEYOR'S SEAL

SIGNED *Kenneth J. Petting* DATE 11-18-66  
REGISTERED LAND SURVEYOR #10068