

*E. Miller*

1993

COMMISSION

CHEBOYGAN COUNTY REMONUMENTATION CORNER  
LAND CORNER RECORDATION CERTIFICATE  
Filing Requirement of Act 74, Mich. P.A. 1970

RECEIVED  
FOR RECORD

93 NOV 24 PM 4: 45

*James H. Granger*  
CLERK/REGISTER  
CHEBOYGAN COUNTY, MICHIGAN

Register of Deeds Stamp & File Number

For corners in

Cheboygan

(County)

Located In:

Corner Code ##

1. Public Land Survey	T	<u>34N</u>	R	<u>2W</u>	<u>M-3</u>
	T	_____	R	_____	_____
	T	_____	R	_____	_____
	T	_____	R	_____	_____
2. Property Controlling in Section	S	_____	T	_____	_____
	S	_____	T	_____	_____
3. Miscellaneous Property in Sec.	S	_____	T	_____	_____
	S	_____	T	_____	_____

- 4. Lot No. \_\_\_\_\_, Recorded Plat \_\_\_\_\_
- 5. Private Claims \_\_\_\_\_

	A	B	C	D	E	F	G	H	I	J	K	L	M
2	6	5	4	3	2	1							
3													
4	7	8	9	10	11	12							
5													
6	18	17	16	15	14	13							
7													
8	19	20	21	22	23	24							
9													
10	30	29	28	27	26	25							
11													
12	31	32	33	34	35	36							
13													

I, James H. Granger, in a field survey on November 1 - 12, 19 93, do hereby certify that under requirements of P.A. 74, Michigan P.A. of 1970, the corner points mentioned in lines 1 and 2 above were in conformance with regulations and rules therefore as required in the current manual of survey instructions of the United States Department of the Interior, Bureau of Land Management or by a decree of a Court of Law and/or that the corner points mentioned in lines 3, 4 and 5 above were in conformance with the rules of the Michigan Board of Land Surveyors or by a Decree of a Court of Law; established, re-established, monumented, re-monumented, recovered, found as expressed below:

NOTE: Not more than 4 corners, all in the same town and range, may be recorded on this certificate.

A. Description of original monument and accessories and/or subsequent restoration:

1840 Original Survey John Mullett  
Set Wood Post  
14" Beech N 68° E 17 lks  
12" Beech S 55° W 29 lks


1909 David Bowen, Co. Surveyor  
1917 David Bowen, Co. Surveyor  
1967 MSHD William Downey #2937

B. Description of corner evidence found and/or method applied in restoring or reestablishing corner:

Fd vertical RR rail  
No witnesses were found

Position accepted as most probable location of original monument set.


*Morris O. Ross*

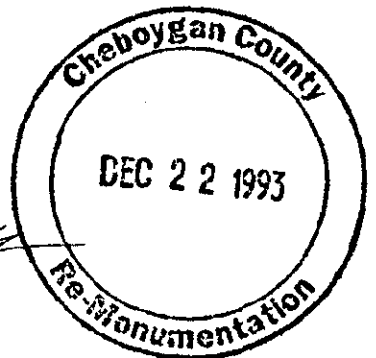

LIBER 010 PAGE 11

C. Description of monument for corner and accessories established to perpetuate locating the position of the corner:

5/8" x 30" rod with 3" dia. alumin. cap  
Power Pole S 33° E 48.15' fd PK nail  
Set nail & tag PS #16041 in:  
6" Apple S 1° W 47.83'  
8" Poplar N 56° W 27.65'  
12" Poplar N 59° E 89.19'

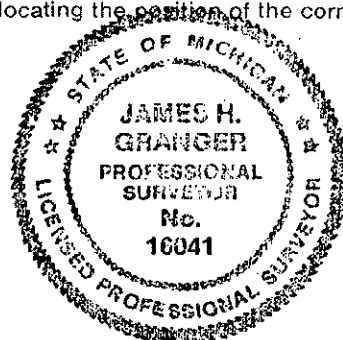

Signed by James H. Granger

Date Nov. 24, 1993

Surveyor's Michigan License No. 16041