

SURVEY & REMONUMENTATION

Ellis

1993

CHEBOYGAN COUNTY REMONUMENTATION CORNER

LAND CORNER RECORDATION CERTIFICATE

Filing Requirement of Act 74, Mich. P.A. 1970

COMMISSION

For corners in
Cheboygan

(County)

Located In:

Corner Code #

1. Public Land Survey	T	<u>34N</u>	R	<u>2W</u>	<u>M-5</u>
	T	_____	R	_____	_____
	T	_____	R	_____	_____
	T	_____	R	_____	_____
2. Property Controlling in Section	S	_____	T	_____	R
	S	_____	T	_____	R
3. Miscellaneous Property in Sec.	S	_____	T	_____	R
	S	_____	T	_____	R

RECEIVED FOR RECORD
93 NOV 24 PM 4:48

Joanna Spray
CLERK/REGISTER
CHEBOYGAN COUNTY Y. MICHIGAN

Register of Deeds Stamp & File Number

4. Lot No. _____, Recorded Plat _____
5. Private Claims _____

A	B	C	D	E	F	G	H	I	J	K	L	M
2	6	5	4	3	2	1						
3												
4	7	8	9	10	11	12						
5												
6	18	17	16	15	14	13						
7												
8	19	20	21	22	23	24						
9												
10	30	29	28	27	26	25						
11												
12	31	32	33	34	35	36						
13												

I, James H. Granger, in a field survey on November 1 - 12, 19 93, do hereby certify that under requirements of P.A. 74, Michigan P.A. of 1970, the corner points mentioned in lines 1 and 2 above were in conformance with regulations and rules theretofore as required in the current manual of survey instructions of the United States Department of the Interior, Bureau of Land Management or by a decree of a Court of Law and/or that the corner points mentioned in lines 3, 4 and 5 above were in conformance with the rules of the Michigan Board of Land Surveyors or by a Decree of a Court of Law; established, re-established, monumented, re-monumented, recovered, found as expressed below.

NOTE: Not more than 4 corners, all in the same town and range, may be recorded on this certificate.


A. Description of original monument and accessories and/or subsequent restoration:

1840 Original Survey John Mullett
Set Wood Post
12" Beech N 48° W 44 lks
10" Hemlock S 40° E 37 lks
1909 Bill Bowen, Co. Surveyor
1922 Bill Bowen, Co. Surveyor
1966 DNR Ken Ostling #10068
1987 Mike Trowbridge #27463

B. Description of corner evidence found and/or method applied in restoring or reestablishing corner:

Fd 8" x 12" stone with "+"
Found 2 1987 witnesses


Marvin A. Bond

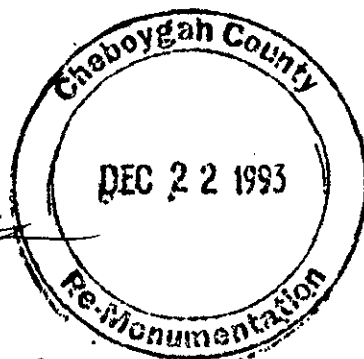

LIBER 010 PAGE 12

C. Description of monument for corner and accessories established to perpetuate locating the position of the corner:

5/8" x 30" rod with 3" dia. alumin. cap
10" Basswood S 62° E 7.70' nail & tag #27463
12" Ash S 29° W 11.66' nail & tag #27463
Set nail and tag PS #16041 in:
8" Elm N 36° E 11.14'
10" Basswood S 85° W 18.40'

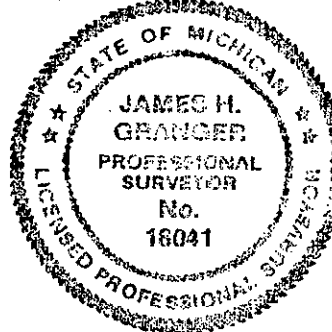

Signed by James H. Granger

Date Nov. 24, 1993

Surveyor's Michigan License No. 16041