

**SURVEY & REMONUMENTATION**

1993

**COMMISSION**

**CHEBOYGAN COUNTY REMONUMENTATION CORNER  
LAND CORNER RECORDATION CERTIFICATE  
Filing Requirement of Act 74, Mich. P.A. 1970**

For corners in  
Cheboygan

(County)

Located In:

Corner Code #

1. Public Land Survey	T	<u>34N</u>	R	<u>2W</u>	M-6
	T	_____	R	_____	_____
	T	_____	R	_____	_____
	T	_____	R	_____	_____
2. Property Controlling in Section	S	_____	T	_____	R
	S	_____	T	_____	R
3. Miscellaneous Property in Sec.	S	_____	T	_____	R
	S	_____	T	_____	R

RECEIVED FOR RECORD

93 NOV 24 PH 4:51

*James H. Granger*  
CLERK/REGISTER  
CHEBOYGAN COUNTY, MICHIGAN

Register of Deeds Stamp & File Number

4. Lot No. \_\_\_\_\_, Recorded Plat \_\_\_\_\_  
5. Private Claims \_\_\_\_\_

	A	B	C	D	E	F	G	H	I	J	K	L	M
2	6		5		4		3		2		1		
3													
4	7		8		9		10		11		12		
5													
6	18		17		16		15		14		13		
7													
8	19		20		21		22		23		24		
9													
10	30		29		28		27		26		25		
11													
12	31		32		33		34		35		36		
13													

I, James H. Granger, in a field survey on November 1 - 12, 19 93, do hereby certify that under requirements of P.A. 74, Michigan P.A. of 1970, the corner points mentioned in lines 1 and 2 above were in conformance with regulations and rules therefore as required in the current manual of survey instructions of the United States Department of the Interior, Bureau of Land Management or by a decree of a Court of Law and/or that the corner points mentioned in lines 3, 4 and 5 above were in conformance with the rules of the Michigan Board of Land Surveyors or by a Decree of a Court of Law; established, re-established, monumented, re-monumented, recovered, found as expressed below:

**NOTE: Not more than 4 corners, all in the same town and range, may be recorded on this certificate.**

A. Description of original monument and accessories and/or subsequent restoration:

1840 Original Survey John Mullett  
Set Wood Post  
10" Sugar S 51° W 8 lks  
10" Lynn N 51° E 32 lks  
1922 Bill Bowen, Co. Surveyor  
1987 Mike Trowbridge

B. Description of corner evidence found and/or method applied in restoring or reestablishing corner:

Found 1/2" rerod with cap #27463  
Found three 1987 witnesses

Position accepted as most probable location of original monument set.


*Michael D. Fox*

LIBER **010** PAGE **13**



C. Description of monument for corner and accessories established to perpetuate locating the position of the corner:

5/8" X 30" rod with 3" dia. alumin. cap  
Fence corner Post South 92.80' nail & tag #27463  
7" Maple S 28° E 29.09' nail & tag #27463  
Set nail & tag PS #16041 in:  
12" Maple S 76° E 29.90'  
6" Aspen N 71° E 14.09'  
N-S fence line East 4.0'

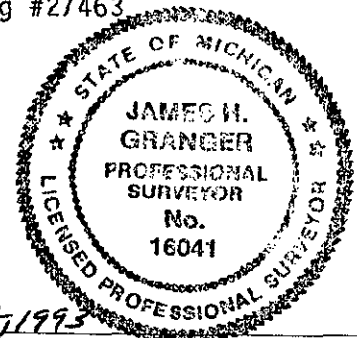

Signed by James H. Granger

Date Nov. 24, 1993

Surveyor's Michigan License No. 16041