

1993

COMMISSION

CHEBOYGAN COUNTY REMONUMENTATION CORNER
LAND CORNER RECORDATION CERTIFICATE
Filing Requirement of Act 74, Mich. P.A. 1970

RECEIVED FOR RECORD

93 DEC 29 PM 2: 26

James Spang
CLERK/REGISTER
CHEBOYGAN COUNTY, MICHIGAN

For corners in

| | | |
|------------------------------------|--------------------------|----------------|
| CHEBOYGAN (County) | Located In: | Corner Code =# |
| 1. Public Land Survey | T <u>34N</u> R <u>2W</u> | <u>M-9</u> |
| | T _____ R _____ | _____ |
| | T _____ R _____ | _____ |
| | T _____ R _____ | _____ |
| 2. Property Controlling in Section | S _____ T _____ R _____ | _____ |
| | S _____ T _____ R _____ | _____ |
| 3. Miscellaneous Property in Sec. | S _____ T _____ R _____ | _____ |
| | S _____ T _____ R _____ | _____ |

Register of Deeds Stamp & File Number

- 4. Lot No. _____, Recorded Plat _____
- 5. Private Claims _____

| A | B | C | D | E | F | G | H | I | J | K | L | M |
|----|----|----|----|----|----|----|---|---|---|---|---|---|
| 2 | 6 | 5 | 4 | 3 | 2 | 1 | | | | | | |
| 3 | | | | | | | | | | | | |
| 4 | 7 | 8 | 9 | 10 | 11 | 12 | | | | | | |
| 5 | | | | | | | | | | | | |
| 6 | 18 | 17 | 16 | 15 | 14 | 13 | | | | | | |
| 7 | | | | | | | | | | | | |
| 8 | 19 | 20 | 21 | 22 | 23 | 24 | | | | | | |
| 9 | | | | | | | | | | | | |
| 10 | 30 | 29 | 28 | 27 | 26 | 25 | | | | | | |
| 11 | | | | | | | | | | | | |
| 12 | 31 | 32 | 33 | 34 | 35 | 36 | | | | | | |
| 13 | | | | | | | | | | | | |

I, Richard C. Dunn, in a field survey on November 1 - 12, 19 93, do hereby certify that under requirements of P.A. 74, Michigan P.A. of 1970, the corner points mentioned in lines 1 and 2 above were in conformance with regulations and rules therefore as required in the current manual of survey instructions of the United States Department of the Interior, Bureau of Land Management or by a decree of a Court of Law and/or that the corner points mentioned in lines 3, 4 and 5 above were in conformance with the rules of the Michigan Board of Land Surveyors or by a Decree of a Court of Law; established, re-established, monumented, re-monumented, recovered, found as expressed below:

NOTE: Not more than 4 corners, all in the same town and range, may be recorded on this certificate.

A. Description of original monument and accessories and/or subsequent restoration:



G.L.O. John Mullett 1840
Set Post Corner Sections
24 & 25 (T34N-R2W) and
Sections 19 & 30 (T34N-R1W)
12" Tamarack N34°W.10.
8" Cedar S48°E.21.

Previously Established by
Marcus Schaaf, RLS #3704.
Previous survey of Township.
Set 1½" Iron Pipe.

Replaced by DNR with 1" Pipe
with 4" aluminum cap,
September 1966 by DNR.
8" B. Ash S30°W.15.5'
12" W. Birch N36°E.22.3'

B. Description of corner evidence found and/or method applied in restoring or reestablishing corner:

Found 1" Iron Pipe with DNR cap as recorded by Department of Natural Resources on November 18, 1966, Cheboygan County L.C.R. Records.

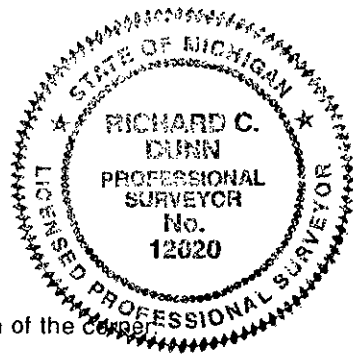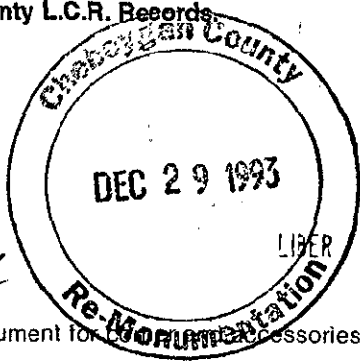

Morris A. Pacy

LIBER 010 PAGE 37

C. Description of monument for re-monumentation accessories established to perpetuate locating the position of the corner:

| | |
|------------------|---|
| M-9 | Found 1" Iron Pipe with DNR cap as recorded in Cheboygan County Records and is accepted as a careful and faithful reestablishment of the position of the original corner. |
| 18" Triple Cedar | S49°E 13.78' Set 60 d Spike |
| 10" Black Ash | S35°W 16.03' Set 60 d Spike |
| 12" Black Ash | N85°W 10.45' Set 60 d Spike |
| 4" Black Ash | N18°E 6.34' Set 60 d Spike |

Signed by Richard C. Dunn

Date December 29, 1993

Surveyor's Michigan License No. 12020