

1993

CHEBOYGAN COUNTY REMONUMENTATION CORNER

LAND CORNER RECORDATION CERTIFICATE

Filing Requirement of Act 74, Mich. P.A. 1970

RECEIVED FOR RECORD

93 DEC 29 PM 2:25

COMMISSION

For corners in

CHEBOYGAN

(County)

Located In:

Corner Code --#

|                                    |       |      |      |
|------------------------------------|-------|------|------|
| 1. Public Land Survey              | T 34N | R 2W | M-10 |
|                                    | T     | R    |      |
|                                    | T     | R    |      |
|                                    | T     | R    |      |
| 2. Property Controlling in Section | S     | T    | R    |
|                                    | S     | T    | R    |
| 3. Miscellaneous Property in Sec.  | S     | T    | R    |
|                                    | S     | T    | R    |

*Jeanne Spray*  
CLERK/REGISTER  
CHEBOYGAN COUNTY, MICHIGAN

Register of Deeds Stamp & File Number

- 4. Lot No. \_\_\_\_\_, Recorded Plat \_\_\_\_\_
- 5. Private Claims \_\_\_\_\_

|    | A  | B  | C  | D  | E  | F  | G | H | I | J | K | L | M |
|----|----|----|----|----|----|----|---|---|---|---|---|---|---|
| 2  | 6  | 5  | 4  | 3  | 2  | 1  |   |   |   |   |   |   |   |
| 3  |    |    |    |    |    |    |   |   |   |   |   |   |   |
| 4  | 7  | 8  | 9  | 10 | 11 | 12 |   |   |   |   |   |   |   |
| 5  |    |    |    |    |    |    |   |   |   |   |   |   |   |
| 6  | 16 | 17 | 18 | 15 | 14 | 13 |   |   |   |   |   |   |   |
| 7  |    |    |    |    |    |    |   |   |   |   |   |   |   |
| 8  | 19 | 20 | 21 | 22 | 23 | 24 |   |   |   |   |   |   |   |
| 9  |    |    |    |    |    |    |   |   |   |   |   |   |   |
| 10 | 30 | 29 | 28 | 27 | 26 | 25 |   |   |   |   |   |   |   |
| 11 |    |    |    |    |    |    |   |   |   |   |   |   |   |
| 12 | 31 | 32 | 33 | 34 | 35 | 36 |   |   |   |   |   |   |   |
| 13 |    |    |    |    |    |    |   |   |   |   |   |   |   |

I, Richard C. Dunn, in a field survey on November 1 - 12, 1993, do hereby certify that under requirements of P.A. 74, Michigan P.A. of 1970, the corner points mentioned in lines 1 and 2 above were in conformance with regulations and rules therefore as required in the current manual of survey instructions of the United States Department of the Interior, Bureau of Land Management or by a decree of a Court of Law and/or that the corner points mentioned in lines 3, 4 and 5 above were in conformance with the rules of the Michigan Board of Land Surveyors or by a Decree of a Court of Law; established, re-established, monumented, re-monumented, recovered, found as expressed below:

**NOTE: Not more than 4 corners, all in the same town and range, may be recorded on this certificate.**

A. Description of original monument and accessories and/or subsequent restoration:


G.L.O. John Mullett 1840  
Set 1/4 Sec. Post Section  
25 T34N-R2W and Section  
30 T34N-R1W  
8" B. Ash S33°W.16.  
6" B. Ash N26°E.11.

Found 2" Pipe and 4" tall  
cedar post by unknown  
surveyor.



B. Description of corner evidence found and/or method applied in restoring or reestablishing corner:

Found 2" Iron Pipe and 4' Tall Cedar Post by unknown Surveyor that fits GLO ties to stream crossings.

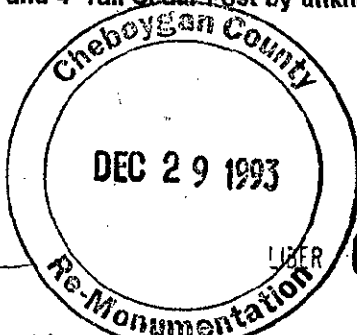

LITER 010 PAGE 36

C. Description of monument for corner and accessories established to perpetuate locating the position of the corner:

M-10 Replaced 2" Pipe with a 5/8" x 30" Iron Rod and 3" Remon. Cap and is accepted as a careful and faithful reestablishment of the position of the original corner.

|           |       |        |                |
|-----------|-------|--------|----------------|
| 14" Ash   | N50°W | 9.42'  | Set 60 d Spike |
| 6" Cedar  | S65°W | 16.15' | Set 60 d Spike |
| 8" Cedar  | S20°E | 18.92' | Set 60 d Spike |
| 15" Cedar | S60°E | 8.91'  | Set 60 d Spike |

Signed by Richard C. Dunn

Date December 29, 1993

Surveyor's Michigan License No. 12020