

1993

COMMISSION

CHEBOYGAN COUNTY REMONUMENTATION CORNER
LAND CORNER RECORDATION CERTIFICATE
Filing Requirement of Act 74, Mich. P.A. 1970

RECEIVED
FOR RECORD

93 DEC 29 PM 2:24

James J. [Signature]
CLERK/REGISTER
CHEBOYGAN COUNTY, MICHIGAN

For corners in

CHEBOYGAN (County)	Located In:	Corner Code #
1. Public Land Survey	T <u>34N</u> R <u>2W</u>	<u>M-11</u>
	T _____ R _____	_____
	T _____ R _____	_____
	T _____ R _____	_____
2. Property Controlling in Section	S _____ T _____ R _____	_____
	S _____ T _____ R _____	_____
3. Miscellaneous Property in Sec.	S _____ T _____ R _____	_____
	S _____ T _____ R _____	_____
4. Lot No. _____, Recorded Plat _____		
5. Private Claims _____		

Register of Deeds Stamp & File Number

I, Richard C. Dunn, in a field survey on November 1 - 12, 19 93, do hereby certify that under requirements of P.A. 74, Michigan P.A. of 1970, the corner points mentioned in lines 1 and 2 above were in conformance with regulations and rules therefore as required in the current manual of survey instructions of the United States Department of the Interior, Bureau of Land Management or by a decree of a Court of Law and/or that the corner points mentioned in lines 3, 4 and 5 above were in conformance with the rules of the Michigan Board of Land Surveyors or by a Decree of a Court of Law; established, re-established, monumented, re-monumented, recovered, found as expressed below:

NOTE: Not more than 4 corners, all in the same town and range, may be recorded on this certificate.

	A	B	C	D	E	F	G	H	I	J	K	L	M
2	6	5	4	3	2	1							
3													
4	7	8	9	10	11	12							
5													
6	18	17	16	15	14	13							
7													
8	19	20	21	22	23	24							
9													
10	30	29	28	27	26	25							
11													
12	31	32	33	34	35	36							
13													

A. Description of original monument and accessories and/or subsequent restoration:

G.L.O. John Mullett 1840
Set Post Corner Sections
25 & 36 (T34N-R2W) and
Sections 30 & 31 (T34N-R1W)
8" Tamarack N43°E.16.
6" Cedar S64°W.16.


Found by Dean Delamater #5778,
1951. Set 1" Pipe with 4" Brass
Cap.
8" Cedar N48°W.24.
10" Cedar S73°E.6.



B. Description of corner evidence found and/or method applied in restoring or reestablishing corner:

Found DNR Monument set by Dean Delamater and whose method of restoration is recorded in Liber A, Page 106, Cheboygan County L.C.R. Records:

The corner was found by Forestry Division survey crew, while working in this area. Corner had been previously located and perpetuated by unknown Surveyor. One original B.T. in place, in good condition. Corner was placed and witnessed August 22, 1951.

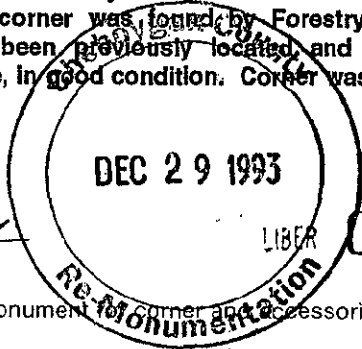

LIBER 010 PAGE 35

C. Description of monument for corner and accessories established to perpetuate locating the position of the corner:

M-11 Found DNR Monument recorded in Liber A, Page 106, Cheboygan County Records, and is accepted as a careful and faithful perpetuation of the position of the original corner.
12" Tamarack N65°E 16.64' Set 60 d Spike
8" Cedar S53°E 18.04' Set 60 d Spike
10" Cedar N50°W 16.33' Set 60 d Spike
4" Cedar S82°W 13.8' Set 60 d Spike

Signed by Richard C. Dunn

Date December 29, 1993

Surveyor's Michigan License No. 12020