

LAND CORNER RECORDATION CERTIFICATE

Filing Requirement of Act 74, Mich. PA 1970

For Corners In: <u>Cheboygan</u> (County)	Located In	Corner Code #	
1. Public Land Survey	T 34N 3W	E-3	
	T _____ R _____		
2. Property Controlling in Section	S 5 T 34N R 3W	3	
	S _____ T _____ R _____		
3. Miscellaneous Property in Section	S _____ T _____ R _____		
	S _____ T _____ R _____		


4. Lot No: _____ Recorded Plat: _____

5. Private Claims: _____

I, Carl T. Kiiskila, in a field survey on March 12, 2008 do hereby state that under requirements of PA 74, Michigan PA of 1970, the corner points mentioned in lines 1 and 2 above were in conformance with regulations and rules therefore as required in the current manual of survey instructions of the United States Department of the Interior, Bureau of Land Management or by a decree of a Court of Law and/or that the corner points mentioned in lines 3, 4 and 5 above were in conformance with the rules of the Michigan Board of Land Surveyors or by a Decree of a Court of Law; established, re-established, monumented, recovered, found as expressed below:

NOTE: Not more than 2 corners, all in the same town and range, may be recorded on this certificate.

Register of Deeds Stamp & File Number

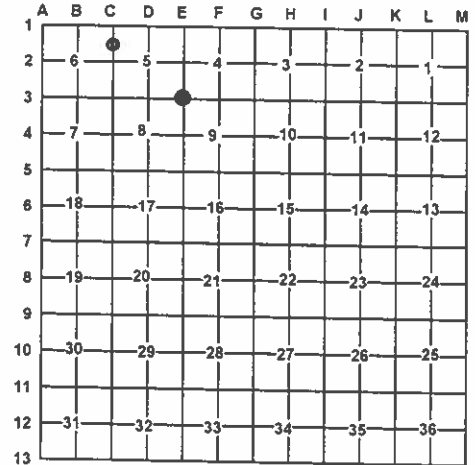

A. Description of original monument and accessories and/or subsequent restoration:

E-3 G.L.O. C.W. Cathcart 1840, Set quarter section post.
 Wit: Sugar 24" S45°W 11 links
 Beech 12" S80°E 16 links

3-This corner position was not established in the original Government Survey.

1961 K.J. Ostling set DNR Monument on line with 1/4 corner and section corner North at proportionate measurement for latitude.

Wits. 12" Elm N 36°E 12.6'
 6" Maple S48°W 32.4'

1988 Liber 1, Page 344 J. Granger Fd 1" pipe with 4" cap
 Wits: 30" Maple N82°W 20.06'
 32" Maple N55°E 69.79'
 10" Poplar S78°E 42.04'
 10" W. Pine S25°W 79.60'

B. Description of corner evidence found and/or method applies in restoring or re-establishing corner:

E-3 Found a DNR Monument bent from heavy equipment
 Removed cap and added to a new 1" pipe.

3-Established the Southwest corner of the Northwest quarter of the Northwest quarter of section 5 as per B.L.M. instructions for the subdivision of a section.

C. Description of monument for corner and accessories established to perpetuate locating the position of the corner:

E-3 Set standard DNR Monument
 Wits: N&T N side 36" Maple N81°W 20.42'
 N&T S side 16" Maple N56°E 69.59'
 N&T S side 12" Oak S66°E 30.47'
 N&T NW side 12" Oak S20°W 56.90'
 N&T NW side 16" R. Pine S27°W 79.69'

3-Set 5/8" x 32" rerod with P.S. cap #33981
 Wits: N&T S side 13" Basswood N63°W 21.30'
 N&T SE side 12" Maple S77°W 40.17'
 N&T SE side 10" Maple S41°W 60.91'
 N&T S side Cor. F. post N74°E 53.97'

Signed by: Carl T. Kiiskila
 Surveyor's Michigan License No.: 33981

Date: 8-18-08

