

SURVEY & REMONUMENTATION

CHEBOYGAN COUNTY REMONUMENTATION CORNER

NOV 05 1997

LAND CORNER RECORDATION CERTIFICATE
Filing Requirement of Act 74, Mich. P.A. 1970

COMMISSION

For corners in
CHEBOYGAN
 (County)

Located In:

Corner Code #

- | | | | | | |
|--------------------------------------|---|------------|---|-----------|------------|
| 1. Public Land Survey | T | <u>34N</u> | R | <u>3W</u> | <u>M-2</u> |
| | T | | R | | |
| | T | | R | | |
| | T | | R | | |
| 2. Property Controlling in Section | S | | T | R | |
| | S | | T | R | |
| 3. Miscellaneous Property in Section | S | | T | R | |
| | S | | T | R | |
4. Lot No. _____, Recorded Plat _____
5. Private Claims _____

RECEIVED FOR RECORD

96 OCT -1 PM 4:02

Joanne Spray

CLERK/REGISTER
 CHEBOYGAN COUNTY, MICHIGAN

Register of Deeds Stamp & File Number

	A	B	C	D	E	F	G	H	I	J	K	L	M
2	6		5		4		3		2		1		
3													
4	7		8		9		10		11		12		
5													
6	18		17		16		15		14		13		
7													
8	19		20		21		22		23		24		
9													
10	30		29		28		27		26		25		
11													
12	31		32		33		34		35		36		
13													

I, Ronald Bischer, in a field survey on August 28, 1996, do hereby certify that under requirements of P.A. 74, Michigan P.A. of 1970, the corner points mentioned in lines 1 and 2 above were in conformance with regulations and rules therefore as required in the current manual of survey instructions of the United States Department of the Interior, Bureau of Land Management or by a decree of a Court of Law and/or that the corner points mentioned in lines 3, 4 and 5 above were in conformance with the rules of the Michigan Board of Professional Surveyors or by a Decree of a Court of Law; established, re-established, monumented, re-monumented, recovered, found as expressed below:

NOTE: Not more than 4 corners, all in the same town and range, may be recorded on this certificate.

A. Description of original monument and accessories and/or subsequent restoration:


1840 GLO Survey - John Mullett
 Set Wood Post
 Y. Pine 16" S14° E 20 lks
 Y. Pine 16" N68° W 18 lks

1973 Peter Chenard #14200
 Found 3/4" PIPE
 Set 3 witnesses


B. Description of corner evidence found and/or method applied in restoring or reestablishing corner:

Found 3/4" pipe and Chenards three witnesses

Set Cheboygan County Remonumentation Monument in 3/4" pipe

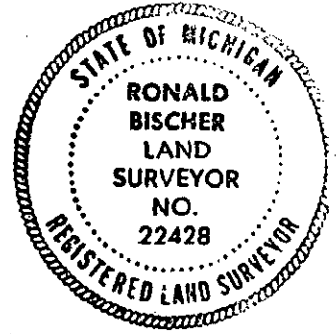

Martin A. Reed

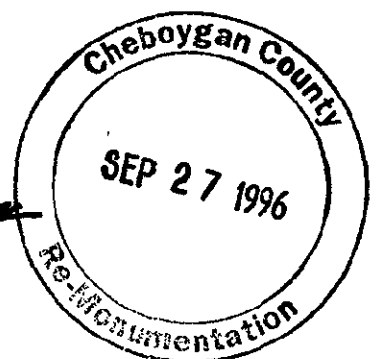

C. Description of monument for corner and accessories established to perpetuate locating the position of the corner:

Cheboygan County Remonumentation Monument

- N45° E 22.00' 12" Red Oak
- S80° E 31.00' 16" White Oak
- S28° W 78.50' 27" White Oak
- N62° W 55.65' 16" White Oak

LIBER **010** PAGE **152**

Signed by Ronald E. Bischer

Date Sept. 18, 1996

Surveyor's Michigan License No. 22428