

MAY 05 1997
COMMISSION

LAND CORNER RECORDATION CERTIFICATE
Filing Requirement of Act 74, Mich. P.A. 1970

For corners in CHEBOYGAN Located in: _____ Corner Code # _____
(County)

1. Public Land Survey	T	<u>34NR</u>	<u>3W</u>	<u>M-4</u>
	T	_____	R	_____
	T	_____	R	_____
	T	_____	R	_____
2. Property Controlling in Section	S	_____	T	_____
	S	_____	T	_____
3. Miscellaneous Property in Section	S	_____	T	_____
	S	_____	T	_____

4. Lot No. _____, Recorded Plat _____

5. Private Claims _____

RECEIVED FOR RECORD

96 OCT -1 PM 4: 04

Josanna Spray
CLERK/REGISTER
CHEBOYGAN COUNTY, MICHIGAN

Register of Deeds Stamp & File Number

	A	B	C	D	E	F	G	H	I	J	K	L	M
2	6		5		4		3		2		1		
3													
4	7		8		9		10		11		12		
5													
6	16		17		18		15		14		13		
7													
8	19		20		21		22		23		24		
9													
10	30		29		28		27		26		25		
11													
12	31		32		33		34		35		36		
13													

I, Ronald Bischer in a field survey on August 28, 19 96, do hereby certify that under requirements of P.A. 74, Michigan P.A. of 1970, the corner points mentioned in lines 1 and 2 above were in conformance with regulations and rules therefore as required in the current manual of survey instructions of the United States Department of the Interior, Bureau of Land Management or by a decree of a Court of Law and/or that the corner points mentioned in lines 3, 4 and 5 above were in conformance with the rules of the Michigan Board of Professional Surveyors or by a Decree of a Court of Law; established, re-established, monumented, re-monumented, recovered, found as expressed below:

NOTE: Not more than 4 corners, all in the same town and range, may be recorded on this certificate.

A. Description of original monument and accessories and/or subsequent restoration:

1840 GLO Survey - John Mullett
Set Wood Post
Beech 8" S13° E 19 lks
Beech 7" N66° W 31 lks

1973 Peter Chenard #14200
Set ½" Rod by single proportion

B. Description of corner evidence found and/or method applied in restoring or reestablishing corner:

Found two of Peter Chenard witnesses

Set Cheboygan County Remonumentation Monument
From Chenard Witnesses




LIBER 010 PAGE 154

C. Description of monument for corner and accessories established to perpetuate locating the position of the corner:

Cheboygan County Remonumentation Monument

N65° E 33.20' 16" Aspen
S67° E 32.86' 18" Aspen
S62° E 19.00' 4" Oak
S04° E 27.05' 12" Maple

Morris A. Rao

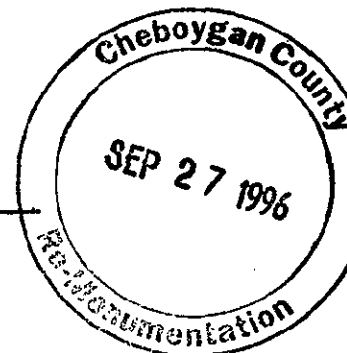

Signed by Ronald R. Bischer

Date Sept. 18, 1996

Surveyor's Michigan License No. 22428