

SURVEY & REMONUMENTATION

CHEBOYGAN COUNTY REMONUMENTATION CORNER

MAY 05 1997

LAND CORNER RECORDATION CERTIFICATE
Filing Requirement of Act 74, Mich. P.A. 1970

For corners in **COMMISSION**
CHEBOYGAN
 (County)

Located In:

Corner Code #

- | | | | | | |
|--------------------------------------|---|------------|---|-----------|------------|
| 1. Public Land Survey | T | <u>34N</u> | R | <u>3W</u> | <u>M-5</u> |
| | T | _____ | R | _____ | _____ |
| | T | _____ | R | _____ | _____ |
| | T | _____ | R | _____ | _____ |
| 2. Property Controlling in Section | S | _____ | T | _____ | R |
| | S | _____ | T | _____ | R |
| 3. Miscellaneous Property in Section | S | _____ | T | _____ | R |
| | S | _____ | T | _____ | R |

4. Lot No. _____, Recorded Plat _____
 5. Private Claims _____

RECEIVED FOR RECORD
 96 OCT -1 PM 4: 05
Jeanne Spray
 CLERK/REGISTER
 CHEBOYGAN COUNTY, MICHIGAN
 Register of Deeds Stamp & File Number

I, Ronald Bischer, in a field survey on August 28, 19 96, do hereby certify that under requirements of P.A. 74, Michigan P.A. of 1970, the corner points mentioned in lines 1 and 2 above were in conformance with regulations and rules therefore as required in the current manual of survey instructions of the United States Department of the Interior, Bureau of Land Management or by a decree of a Court of Law and/or that the corner points mentioned in lines 3, 4 and 5 above were in conformance with the rules of the Michigan Board of Professional Surveyors or by a Decree of a Court of Law; established, re-established, monumented, re-monumented, recovered, found as expressed below:

	A	B	C	D	E	F	G	H	I	J	K	L	A
2	6		5		4		3		2		1		
3													
4	7		8		9		10		11		12		
5													
6	18		17		16		15		14		13		
7													
8	19		20		21		22		23		24		
9													
10	30		29		28		27		26		25		
11													
12	31		32		33		34		35		36		
13													

NOTE: Not more than 4 corners, all in the same town and range, may be recorded on this certificate.

A. Description of original monument and accessories and/or subsequent restoration:

1840 Glo Survey - John Mullett
 Set Wood Post
 Beech 10" N14° W 22 lks
 Beech 7" S33° W 50 lks

1973 Peter Chenard #14200
 Found 1/2" Rod
 Set 3 witnesses


1960 Dean DelaMeter #5778
 Found 1/2" Rod
 Set 3 witnesses

1988 James Granger #16041
 Found 1/2" Rod
 Set 4 witnesses

B. Description of corner evidence found and/or method applied in restoring or reestablishing corner:

Found 1/2" Rod and three Chenard witnesses and two old MSHD witnesses

Replaced with Cheboygan County Remonumentation Monument

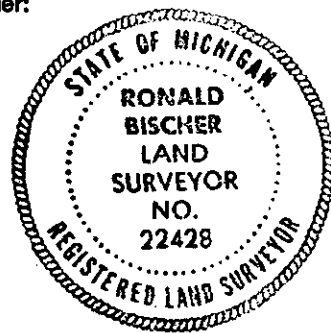


C. Description of monument for corner and accessories established to perpetuate locating the position of the corner:

Cheboygan County Remonumentation Monument

- N80° W 15.67' 10" Maple
- N60° E 35.95' 20" Maple
- S07° W 13.48' 10" Maple
- S84° E 46.97' 20" Maple

LIBER 010 PAGE 155

Morris A. Rose

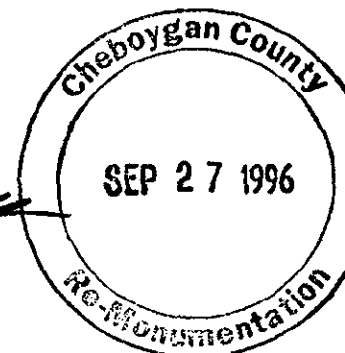

Signed by Ronald R. Bischer

Date Sept. 18, 1996

Surveyor's Michigan License No. 22428