

SURVEY & REMONUMENTATION

MAY 05 1997
COMMISSION

CHEBOYGAN COUNTY REMONUMENTATION CORNER

LAND CORNER RECORDATION CERTIFICATE
Filing Requirement of Act 74, Mich. P.A. 1970

For corners in <u>CHEBOYGAN</u> (County)	Located In:	Corner Code #
1. Public Land Survey	T <u>34N</u> R <u>3W</u>	<u>M-6</u>
	T _____ R _____	_____
	T _____ R _____	_____
	T _____ R _____	_____
2. Property Controlling in Section	S _____ T _____ R _____	_____
	S _____ T _____ R _____	_____
3. Miscellaneous Property in Section	S _____ T _____ R _____	_____
	S _____ T _____ R _____	_____
4. Lot No. _____, Recorded Plat _____		
5. Private Claims _____		

RECEIVED
FOR RECORD
96 OCT -1 PM 4:08
James Gray
CLERK/REGISTER
CHEBOYGAN COUNTY, MICHIGAN
Register of Deeds Stamp & File Number


	A	B	C	D	E	F	G	H	I	J	K	L	M
2	6		5		4		3		2		1		
3													
4	7		8		9		10		11		12		
5													
6	18		17		16		15		14		13		
7													
8	19		20		21		22		23		24		
9													
10	30		29		28		27		26		25		
11													
12	31		32		33		34		35		36		
13													

I, Ronald Bischer in a field survey on August 29, 1996, do hereby certify that under requirements of P.A. 74, Michigan P.A. of 1970, the corner points mentioned in lines 1 and 2 above were in conformance with regulations and rules therefore as required in the current manual of survey instructions of the United States Department of the Interior, Bureau of Land Management or by a decree of a Court of Law and/or that the corner points mentioned in lines 3, 4 and 5 above were in conformance with the rules of the Michigan Board of Professional Surveyors or by a Decree of a Court of Law; established, re-established, monumented, re-monumented, recovered, found as expressed below:

NOTE: Not more than 4 corners, all in the same town and range, may be recorded on this certificate.

- A. Description of original monument and accessories and/or subsequent restoration:**
- | | |
|---|--|
| 1840 GLO Survey - John Mullett
Set Wood Post
Lynn 12" N30° W 3 lks
Lynn 6" S30° E 7 lks. | 1988 James Granger #16041
Found 2" pipe and set
four witnesses |
| 1961 Stanley Thorsen #5788
Found 2" pipe
Set three witnesses | 1994 Michael Trowbridge #27463
Found 2" pipe |

- B. Description of corner evidence found and/or method applied in restoring or reestablishing corner:**
- Found 2" O.D. pipe and two Thorsen witnesses and two Porter #15410 witnesses
- Set Cheboygan County Remonumentation Monument in 2" pipe

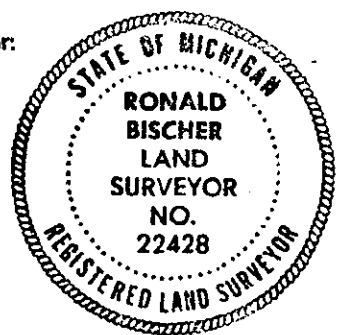


LIBER **010** PAGE **156**

- C. Description of monument for corner and accessories established to perpetuate locating the position of the corner:**
- Cheboygan County Remonumentation Monument

- S40° W 7.04' 6" Beech
- N81° W 5.83' 6" Maple
- N70° E 8.79' 6" Maple
- S31° E 4.33' 6" Maple

Marvin A. Rose

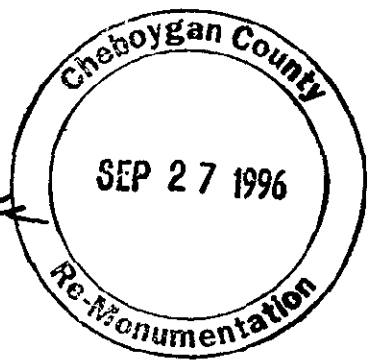

Signed by Ronald R. Bischer
Surveyor's Michigan License No. 22428

Date Sept. 18, 1996