

SURVEY & REMONUMENTATION

CHEBOYGAN COUNTY REMONUMENTATION CORNER

LAND CORNER RECORDATION CERTIFICATE

Filing Requirement of Act 74, Mich. P.A. 1970

For corners in **CHEBOYGAN**
(County)

Located In: _____ Corner Code # _____

- 1. Public Land Survey T 34N R 3W M-7
- T _____ R _____
- T _____ R _____
- T _____ R _____
- 2. Property Controlling S _____ T _____ R _____
- In Section S _____ T _____ R _____
- 3. Miscellaneous S _____ T _____ R _____
- Property in Section S _____ T _____ R _____
- 4. Lot No. _____, Recorded Plat _____
- 5. Private Claims _____

RECEIVED FOR RECORD

96 OCT -1 PM 4:11

Joanna Spray

CLERK/REGISTER
CHEBOYGAN COUNTY, MICHIGAN

Register of Deeds Stamp & File Number

I, Ronald Bischer, in a field survey on August 29, 1996, do hereby certify that under requirements of P.A. 74, Michigan P.A. of 1970, the corner points mentioned in lines 1 and 2 above were in conformance with regulations and rules therefore as required in the current manual of survey instructions of the United States Department of the Interior, Bureau of Land Management or by a decree of a Court of Law and/or that the corner points mentioned in lines 3, 4 and 5 above were in conformance with the rules of the Michigan Board of Professional Surveyors or by a Decree of a Court of Law; established, re-established, monumented, re-monumented, recovered, found as expressed below:

NOTE: Not more than 4 corners, all in the same town and range, may be recorded on this certificate.

	A	B	C	D	E	F	G	H	I	J	K	L	M
2	6		5		4		3		2		1		
3													
4	7		8		9		10		11		12		
5													
6	18		17		16		15		14		13		
7													
8	19		20		21		22		23		24		
9													
10	30		29		28		27		26		25		
11													
12	31		32		33		34		35		36		
13													

A. Description of original monument and accessories and/or subsequent restoration:

1840 GLO Survey - John Mullett
Set Wood Post
Sugar 20" S23° E 14 lks
Hemlock 12" N24° W 20 lks

1994 Michael Trowbridge #27463
Found 1½" Wellpoint and witnesses. Set three new witnesses

1961 Orlando Doyle #7319
Found 1½" Wellpoint
Set 3 witnesses

B. Description of corner evidence found and/or method applied in restoring or reestablishing corner:

Found 1½" Wellpoint and One Doyle witness and three Trowbridge witnesses

Set Cheboygan County Remonumentation Monument in 1½" Wellpoint




LIBER 010 PAGE 157

C. Description of monument for corner and accessories established to perpetuate locating the position of the corner:

Cheboygan County Remonumentation Monument

- N75° E 10.60' 11" Aspen
- N27° E 10.15' 5" Maple
- N51° W 19.54' 8" Maple
- S33° E 13.73' 5" Maple

Marcia Rae

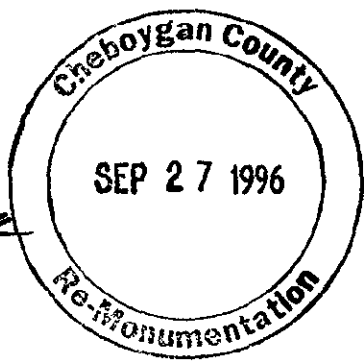

Signed by Ronald R. Bischer

Date Sept. 18, 1996

Surveyor's Michigan License No. 22428