

**SURVEY &
REMONUMENTATION** CHEBOYGAN COUNTY REMONUMENTATION CORNER

MAY 05 1997

LAND CORNER RECORDATION CERTIFICATE
Filing Requirement of Act 74, Mich. P.A. 1970

For corners in CHEBOYGAN
(County)

Located In:	Corner Code #
1. Public Land Survey	T <u>34N</u> R <u>3W</u> <u>M-9</u>
	T _____ R _____
	T _____ R _____
	T _____ R _____
2. Property Controlling in Section	S _____ T _____ R _____
	S _____ T _____ R _____
3. Miscellaneous Property in Section	S _____ T _____ R _____
	S _____ T _____ R _____

RECEIVED FOR RECORD

96 OCT -1 PM 4:14

James Spray
CLERK/REGISTER
CHEBOYGAN COUNTY, MICHIGAN

Register of Deeds Stamp & File Number

4. Lot No. _____, Recorded Plat _____
5. Private Claims _____

A	B	C	D	E	F	G	H	I	J	K	L	M
2	6	5	4	3	2	1						
3												
4	7	8	9	10	11	12						
5												
6	18	17	16	15	14	13						
7												
8	19	20	21	22	23	24						
9												
10	30	29	28	27	26	25						
11												
12	31	32	33	34	35	36						
13												

I, Ronald Bischer, in a field survey on August 30, 1996, do hereby certify that under requirements of P.A. 74, Michigan P.A. of 1970, the corner points mentioned in lines 1 and 2 above were in conformance with regulations and rules therefore as required in the current manual of survey instructions of the United States Department of the Interior, Bureau of Land Management or by a decree of a Court of Law and/or that the corner points mentioned in lines 3, 4 and 5 above were in conformance with the rules of the Michigan Board of Professional Surveyors or by a Decree of a Court of Law; established, re-established, monumented, re-monumented, recovered, found as expressed below:

NOTE: Not more than 4 corners, all in the same town and range, may be recorded on this certificate.

A. Description of original monument and accessories and/or subsequent restoration:

1840 GLO Survey - John Mullett
Set Wood Post
Beech 10" S45° W 22 lks
Beech 7 " N22° W 32 lks

1960 Dean DelaMeter #5778
Found 3/4" pipe
Set 2 witnesses

1952 Orlando Doyle #7319
Set 3/4" pipe
Set 3 witnesses

1994 Michael Trowbridge #27463
Found 3/4" pipe and DelaMeter
Witness
Set 4 new witnesses

B. Description of corner evidence found and/or method applied in restoring or reestablishing corner:

Found 3/4" pipe in concrete
Also found 2 DelaMeter witnesses
and 4 Trowbridge witnesses

Set Cheboygan County Remonumentation Monument




LIBER 010 PAGE 159

C. Description of monument for corner and accessories established to perpetuate locating the position of the corner:

Cheboygan County Remonumentation Monument

S59° W 16.46' 8" Aspen
N23° W 9.05' 5" Maple
N60° E 11.20' 4" Maple
South 0.75' Steel Fence Post

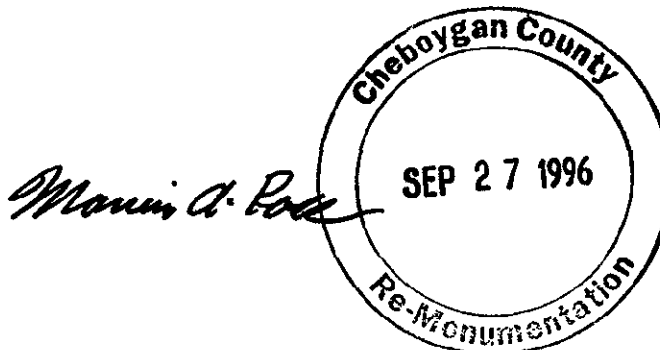

Signed by Ronald B. Bischer

Date Sept. 18, 1996

Surveyor's Michigan License No. 22428