

CHEBOYGAN COUNTY REMONUMENTATION CORNER

**LAND CORNER RECORDATION CERTIFICATE**  
**Filing Requirement of Act 74, Mich. P.A. 1970**

For corners in  
CHEBOYGAN  
 (County)

Located In:

Corner Code #

- |                                      |   |            |   |           |             |       |
|--------------------------------------|---|------------|---|-----------|-------------|-------|
| 1. Public Land Survey                | T | <u>34N</u> | R | <u>3W</u> | <u>M-11</u> |       |
|                                      | T | _____      | R | _____     | _____       |       |
|                                      | T | _____      | R | _____     | _____       |       |
|                                      | T | _____      | R | _____     | _____       |       |
| 2. Property Controlling in Section   | S | _____      | T | _____     | R           | _____ |
|                                      | S | _____      | T | _____     | R           | _____ |
| 3. Miscellaneous Property in Section | S | _____      | T | _____     | R           | _____ |
|                                      | S | _____      | T | _____     | R           | _____ |

RECEIVED FOR RECORD  
 96 OCT -1 PM 4:16  
 CHEBOYGAN COUNTY  
*Jenna Gray*  
 CLERK/REGISTER  
 Register of Deeds Stamp & File Number

4. Lot No. \_\_\_\_\_, Recorded Plat \_\_\_\_\_  
 5. Private Claims \_\_\_\_\_

	A	B	C	D	E	F	G	H	I	J	K	L	M
2	6		5		4		3		2				
3													
4	7		8		9		10		11		12		
5													
6	18		17		16		15		14		13		
7													
8	19		20		21		22		23		24		
9													
10	30		29		28		27		26		25		
11													
12	31		32		33		34		35		36		
13													

I, Ronald Bischer, in a field survey on August 30, 19 96, do hereby certify that under requirements of P.A. 74, Michigan P.A. of 1970, the corner points mentioned in lines 1 and 2 above were in conformance with regulations and rules therefore as required in the current manual of survey instructions of the United States Department of the Interior, Bureau of Land Management or by a decree of a Court of Law and/or that the corner points mentioned in lines 3, 4 and 5 above were in conformance with the rules of the Michigan Board of Professional Surveyors or by a Decree of a Court of Law; established, re-established, monumented, re-monumented, recovered, found as expressed below:

**NOTE: Not more than 4 corners, all in the same town and range, may be recorded on this certificate.**

**A. Description of original monument and accessories and/or subsequent restoration:**


1840 GLO Survey - John Mullett  
 Set Wood Post  
 Hemlock 16" N15° W 5 lks  
 Hemlock 16" S65° W 16 lks

1993 Richard Dunn #12020  
 Set 1/2" Rod and Cap  
 Set 4 Witnesses

**B. Description of corner evidence found and/or method applied in restoring or reestablishing corner:**

Found 1/2" Rod&Cap #12020 and Four Witnesses

Replaced 1/2" Rod & Cap with a Cheboygan County Remonumentation Monument

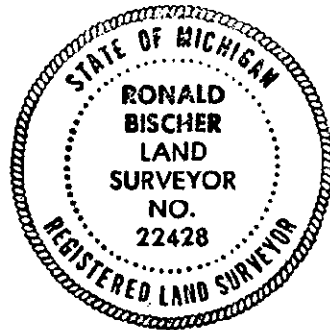


LIBER **010** PAGE **161**

**C. Description of monument for corner and accessories established to perpetuate locating the position of the corner:**

Cheboygan County Remonumentation Monument

- S87° W 16.30' 8" Aspen
- N40° W 26.46' 12" Maple
- N21° W 24.70' 6" Lynn
- N68° E 16.80' 4" Ash

*Marvin A. Rose*

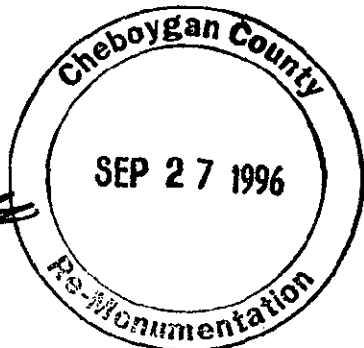

Signed by Ronald R. Bischer

Date Sept 18, 1996

Surveyor's Michigan License No. 22428