

SURVEY & REMONUMENTATION

MAY 05 1997

COMMISSION

RE MONUMENTATION LAND CORNER RECORDATION CERTIFICATE
Filing Requirement of Act 74, Mich. P.A. 1970

For corners in

Cheboygan

(County)

Located In:

Corner Code #

1. Public Land Survey

T 34N R 3W

M-12

T _____ R _____

T _____ R _____

T _____ R _____

T _____ R _____

2. Property Controlling in Section

S _____

T _____ R _____

S _____

T _____ R _____

3. Miscellaneous Property in Sec.

S _____

T _____ R _____

S _____

T _____ R _____

4. Lot No. _____, Recorded Plat _____

5. Private Claims _____

Brian K. Fullford

in a field survey on August, 1996

do hereby state that under requirements of P.A. 74, Michigan P.A. of 1970, the corner points mentioned in lines 1 and 2 above were in conformance with regulations and rules therefore as required in the current manual of survey instructions of the United States Department of the Interior, Bureau of Land Management or by a decree of a Court of Law and/or that the corner points mentioned in lines 3, 4 and 5 above were in conformance with the rules of the Michigan Board of Land Surveyors or by a Decree of a Court of Law; established, re-established, monumented, recovered, found as expressed below:

NOTE: Not more than 2 corners, all in the same town and range, may be recorded on this certificate.

A. Description of original monument and accessories and/or subsequent restoration:

G.L.O.
 Set 1/4 Section Post
 18" Hemlock N70°E 5 Links
 8" Cedar S82°W 18 Links

1978 Unrecorded Survey By R.C.Dunn
 No Wits or Corner Identified

1995 Unrecorded LCRC
 By Porter Survey
 Set By Single Proportion
 8" Aspen N87°W 13.94'
 6" Aspen N01°E 18.35'
 8" Aspen N61°E 13.19'
 5" Ash S04°E 4.92'
 Set by Single Proportion

B. Description of corner evidence found and/or method applied in restoring or reestablishing corner:

Fd 1/2" Bar & Cap #33984
 8" Aspen N87°W 13.94'
 6" Aspen N01°E 18.35'
 8" Aspen N61°E 13.19'
 5" Ash S04°E 4.92'

LIBER 010 PAGE 202



C. Description of monument for corner and accessories established to perpetuate locating the position of the corner:


M-12 Fnd 1/2" Bar & Cap #33984, Replaced with 5/8" x 36" Bar with Remonumentation Cap. Accepted as a careful & faithful re-establishment of the position of the original corner.

6" Aspen N01°E 18.35'
 8" Aspen N61°E 13.19'
 5" Ash S04°E 4.92'
 8" Aspen N87°W 13.94'
 On Se'ly Edge of Old R.R. Grade Sw'ly 100'
 To River Nw'ly 70' to River

THIS CORNER IS ALSO DESIGNATED AS CORNER CODE #A-12, IN T34N-R2W.

Signed by B. K. Fullford
 Surveyor's Michigan License No. 41099
 Brian K. Fullford, PS

Date 10/22/96

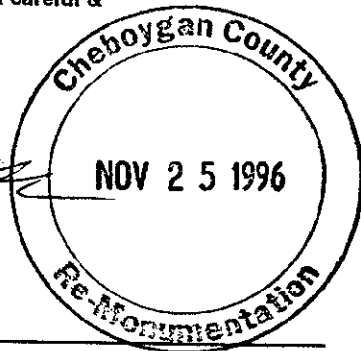

RECEIVED FOR RECORD
 96 NOV 25 PM 12:59
Joanna Gray
 CLERK/REGISTER
 CHEBOYGAN COUNTY, MICHIGAN

Register of Deeds Stamp & File Number

	A	B	C	D	E	F	G	H	I	J	K	L	M
1													
2	6		5		4		3		2		1		
3													
4	7		8		9		10		11		12		
5													
6	18		17		16		15		14		13		
7													
8	19		20		21		22		23		24		
9													
10	30		29		28		27		26		25		
11													
12	31		32		33		34		35		36		
13													