

SURVEY & REMONUMENTATION

Mont
MAY 05 1997

**RE MONUMENTATION
LAND CORNER RECORDATION CERTIFICATE
Filing Requirement of Act 74, Mich. P.A. 1970**

RECEIVED FOR RECORD

96 NOV 25 PM 1:00

Josanna Gray
CLERK/REGISTER
CHEBOYGAN COUNTY, MICHIGAN

For corners in **COMMISSION**

Cheboygan (County)	Located In:	Corner Code #
1. Public Land Survey	T <u>34N</u> R <u>3W</u>	M-13
	T <u> </u> R <u> </u>	_____
	T <u> </u> R <u> </u>	_____
	T <u> </u> R <u> </u>	_____
	T <u> </u> R <u> </u>	_____
2. Property Controlling in Section	S <u> </u> T <u> </u> R <u> </u>	_____
	S <u> </u> T <u> </u> R <u> </u>	_____
3. Miscellaneous Property in Sec.	S <u> </u> T <u> </u> R <u> </u>	_____
	S <u> </u> T <u> </u> R <u> </u>	_____

Register of Deeds Stamp & File Number

4. Lot No. _____, Recorded Plat _____
5. Private Claims _____

I, Brian K. Fullford, in a field survey on August, 19 96 do hereby state that under requirements of P.A. 74, Michigan P.A. of 1970, the corner points mentioned in lines 1 and 2 above were in conformance with regulations and rules therefore as required in the current manual of survey instructions of the United States Department of the Interior, Bureau of Land Management or by a decree of a Court of Law and /or that the corner points mentioned in lines 3, 4 and 5 above were in conformance with the rules of the Michigan Board of Land Surveyors or by a Decree of a Court of Law; established, re-established, monumented, recovered, found as expressed below.

NOTE: Not more than 2 corners, all in the same town and range, may be recorded on this certificate.

	A	B	C	D	E	F	G	H	I	J	K	L	M
1													
2	6		5		4		3		2		1		
3													
4	7		8		9		10		11		12		
5													
6	18		17		16		15		14		13		
7													
8	19		20		21		22		23		24		
9													
10	30		29		28		27		26		25		
11													
12	31		32		33		34		35		36		
13													

- A. Description of original monument and accessories and/or subsequent restoration:
- | | | | |
|--|--|--|--|
| G.L.O.
Set Township Corner
10" Sugar N25°E 12 Links
8" Sugar S65°W 10 Links | 1973 Recorded Survey
Liber 336, Page 433
By R.C. Dunn #12020
Survey Showing Tie to Section Corner | 1976 Unrecorded Survey
By George Henning #2240
1" Pipe In 2" Pipe
MSHD Witness Tags | 1995 Unrecorded LCRC
By Norm Quaine #33984
1" Pipe Inside 2" Pipe
N76°E 15.11' 11" Spruce
S73°E 23.35' 9" Ironwood
S44°E 23.22' 17" Aspen
S10°W 19.10' 22" Aspen |
|--|--|--|--|

- B. Description of corner evidence found and/or method applied in restoring or reestablishing corner:
- Found 1" Pipe Inside 2" Pipe
11" Spruce N76°E 14.93'
9" Ironwood S73°E 22.53'
17" Aspen S44°E 21.85'
22" Aspen S10°W 18.02'


LIBER 010 PAGE 203



- C. Description of monument for corner and accessories established to perpetuate locating the position of the corner:

M-13 Found 1" Pipe Inside 2" Pipe #15410. Replaced with 5/8" x 36" Bar with Remonumentation Cap. Accepted as a careful & faithful re-establishment of the position of the original corner.

11" Spruce N76°E 14.93'
9" Ironwood S73°E 22.53'
17" Aspen S44°E 21.85'
22" Aspen S10°W 18.02'

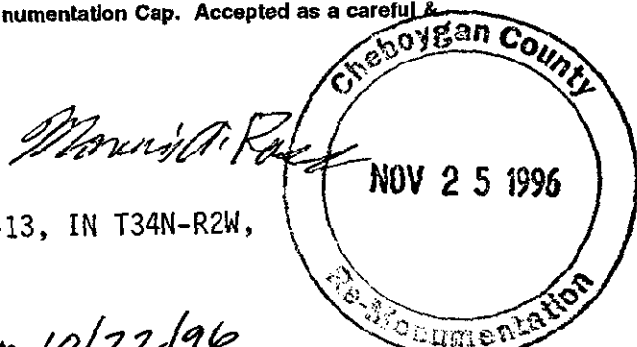

THIS CORNER IS ALSO DESIGNATED AS CORNER CODES #A-13, IN T34N-R2W, #A-1, IN T33N-R2W AND #M-1, IN T33N-R3W.

Signed by Brian K. Fullford
Surveyor's Michigan License No. 41099
Brian K. Fullford, PS

Date 10/22/96