

MICHIGAN
DEPARTMENT OF CONSERVATION
FORESTRY DIVISION

LAND CORNER RECORD

T. 34 N.R. 3 W


Cheboygan COUNTY

DESCRIPTION OF CORNER Section corner common to Sections 20-21-22-23

CORNER MONUMENT Left 2½" pipe in place

DATE MONUMENT PLACED AND WITNESSED 6/26/61

WITNESSES TO CORNER.....

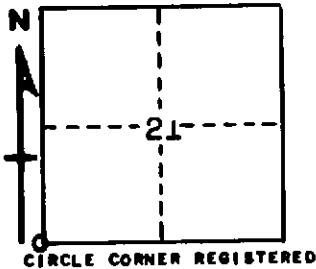

14" Elm - N16E - 60.8 ft

6" Elm - N76W - 63.4 ft

AND Corner fence post - S53E - 30.9 ft

DESCRIPTION IN DETAIL AS TO HOW CORNER WAS LOCATED AND IDENTIFIED OR RESTORED.

This corner was found by Forestry Division survey crew while making a survey in this township. Found a 2½" pipe with cap at intersection of old township roads N-S-E-W. Appears to have been accepted by adjacent occupation and is considered best available evidence of proper location for corner.

SURVEYOR'S SEAL

SIGNED *Kevin J. Dethling* DATE 7/5/61
REGISTERED LAND SURVEYOR