

MICHIGAN
DEPARTMENT OF CONSERVATION
FORESTRY DIVISION

LAND CORNER RECORD

T. 34N N.R. 3W


Cheboygan COUNTY

DESCRIPTION OF CORNER Closing Corner common to sections 3 and 4 on North boundary
of township.

CORNER MONUMENT 1" pipe with 4" brass cap.

DATE MONUMENT PLACED AND WITNESSED May 31, 1961

WITNESSES TO CORNER.....

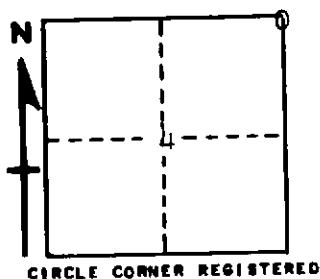

1 1/2" Jack Pine S 89 E 27.3 ft.

7" W. Pine S 49 W 77.9 ft.

AND

DESCRIPTION IN DETAIL AS TO HOW CORNER WAS LOCATED AND IDENTIFIED OR RESTORED.

This corner was established at record measurement east of standard corner on this town line. Unable to identify government B. T.'s.

Corner to sections 33 and 34, T35N, R3W is 90 links west.

SURVEYOR'S SEAL

SIGNED *Kenneth J. Ostling* DATE June 6, 1961
REGISTERED LAND SURVEYOR