

MICHIGAN  
DEPARTMENT OF CONSERVATION  
FORESTRY DIVISION

# LAND CORNER RECORD

T. 34 N.R. 3 W


Cheboygan COUNTY

DESCRIPTION OF CORNER 1/4 corner common to Sections 15 and 16

CORNER MONUMENT 1" pipe with 4" brass cap

DATE MONUMENT PLACED AND WITNESSED 6/29/61

WITNESSES TO CORNER.....

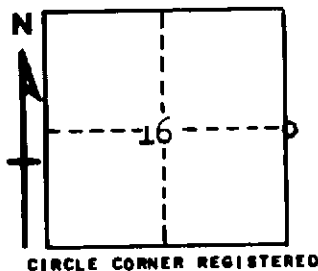

5" Maple - N15E - 11.8 ft

5" Maple - S51E - 7.3 ft

AND

DESCRIPTION IN DETAIL AS TO HOW CORNER WAS LOCATED AND IDENTIFIED OR RESTORED.

This corner was set by proportionate measurement, midpoint on line, between section corners. A few Hemlock sites in vicinity but unable to positively identify government BTs.

SURVEYOR'S SEAL

SIGNED Kenneth J. Petting DATE 7/6/61  
REGISTERED LAND SURVEYOR