

MICHIGAN
DEPARTMENT OF CONSERVATION
FORESTRY DIVISION

LAND CORNER RECORD

T. 34 N.R. 3 W


Cheboygan COUNTY

DESCRIPTION OF CORNER 1/4 corner common to Sections 7 and 8

CORNER MONUMENT Left 1 1/4" pipe in place

DATE MONUMENT PLACED AND WITNESSED 6/29/61

WITNESSES TO CORNER.....

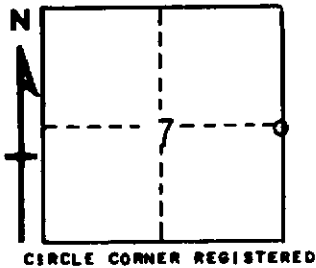

18" Elm - S79E - 21.8 ft

18" Elm - N44W - 29.1 ft

AND

DESCRIPTION IN DETAIL AS TO HOW CORNER WAS LOCATED AND IDENTIFIED OR RESTORED.

This corner was found by Forestry Division survey crew while making a survey in this area. Found 1 1/4" pipe in N-S county road in line with old fences east and west. Appears acceptable as the corner.

SURVEYOR'S SEAL

SIGNED Kenneth J. Oetting DATE 7/6/61
REGISTERED LAND SURVEYOR