

MICHIGAN
DEPARTMENT OF CONSERVATION
FORESTRY DIVISION

LAND CORNER RECORD

T. 34 N. R. 3 W


Cheboygan COUNTY

DESCRIPTION OF CORNER Section corner Common to Sections 5-6-7-8

CORNER MONUMENT Left 1½" pipe in place in road

DATE MONUMENT PLACED AND WITNESSED 6/29/61

WITNESSES TO CORNER.....

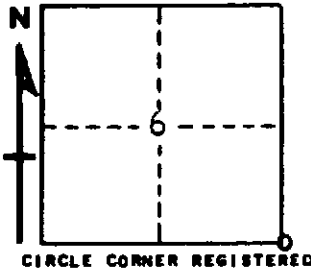

8" Cedar - N48W - 42.0 ft

7" Tamarack - S73W - 76.4 ft

AND

DESCRIPTION IN DETAIL AS TO HOW CORNER WAS LOCATED AND IDENTIFIED OR RESTORED.

This corner was found by Forestry Division survey crew during survey project in this area. Located 1½" pipe in county road in line with old fence east. Appears to have been accepted as corner by adjoining occupation, and can find no evidence to the contrary.

SURVEYOR'S SEAL

SIGNED *Kenneth J. Ostling* DATE 7/5/61
REGISTERED LAND SURVEYOR