

MICHIGAN
DEPARTMENT OF CONSERVATION
FORESTRY DIVISION

LAND CORNER RECORD

T. 34 N.R. 3 W


Cheboygan COUNTY

DESCRIPTION OF CORNER 1/4 corner common to Sections 4 and 5

CORNER MONUMENT 1" pipe with 4" brass cap

DATE MONUMENT PLACED AND WITNESSED 6/29/61

WITNESSES TO CORNER.....

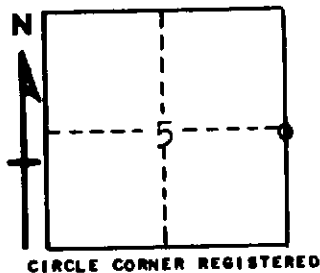

7" Elm - N18W - 11.6 ft

4" Ironwood - N88E - 20.6 ft

AND

DESCRIPTION IN DETAIL AS TO HOW CORNER WAS LOCATED AND IDENTIFIED OR RESTORED.

This corner was found by Forestry Division survey crew while making a survey in this area. Found a 1/2" pipe at corner, in line with old road grade north and midway between lane fences south. Origin unknown but checks acceptably to Section corner north and was considered acceptable as best available evidence.

SURVEYOR'S SEAL

SIGNED Kenneth J. Ostby DATE 7/5/61
REGISTERED LAND SURVEYOR