

MICHIGAN
DEPARTMENT OF CONSERVATION
FORESTRY DIVISION

LAND CORNER RECORD

T. 34 N.R. 3 W


Cheboygan COUNTY

DESCRIPTION OF CORNER Section corner common to Sections 3-4-9-10

CORNER MONUMENT 1" pipe with 4" brass cap

DATE MONUMENT PLACED AND WITNESSED 6/28/61

WITNESSES TO CORNER.....

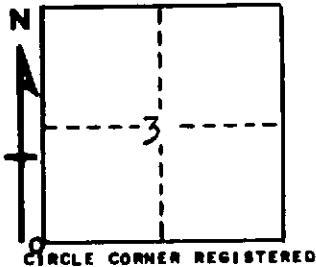

8" Twin Maple - N70W - 40.9 ft

9" J. Pine - N22E - 18.6 ft

AND 6" J. Pine - S49E - 35.5 ft

DESCRIPTION IN DETAIL AS TO HOW CORNER WAS LOCATED AND IDENTIFIED OR RESTORED.

This corner was restored by proportionate measurement between corners 1 mile north, 3 mile south, 1 mile east and 1 mile west. Several pine stumps in vicinity but unable to positively identify government corner.

SURVEYOR'S SEAL

SIGNED Kenneth J. Ostling DATE 7/5/61
REGISTERED LAND SURVEYOR