

MICHIGAN  
DEPARTMENT OF CONSERVATION  
FORESTRY DIVISION

# LAND CORNER RECORD

T. 34 N.R. 3 W


Cheboygan COUNTY

DESCRIPTION OF CORNER Section corner common to Sections 10-11-15-14

CORNER MONUMENT 1" pipe with 4" brass cap

DATE MONUMENT PLACED AND WITNESSED 6/27/61

WITNESSES TO CORNER.....

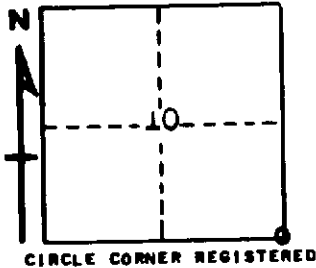

22" Elm - N2E - 60.0 ft

6" W. Pine - S27E - 33.8 ft

AND

**DESCRIPTION IN DETAIL AS TO HOW CORNER WAS LOCATED AND IDENTIFIED OR RESTORED.**

This corner was restored by Forestry Division survey crew while making a survey in this area. Set corner by proportionate measurement for latitude between corners 1 mile north and 1 mile south, at Bowen's record measurement from 1/4 corner between Sections 11 and 14. Corner now falls in center of Berry Creek, but the possibility of a stream change in this area is present, and it was assumed that Bowen's 1908 survey had the support of any government evidence, if such evidence did exist. The government survey placed the corner 1 chain west of the stream, but as previously noted, the stream course may have changed, and the priority of the Bowen survey was given consideration. Section 14 appears to have been occupied on the basis of the Bowen survey, and an attempt to restore his survey was considered more justifiable than a technical restoration by double proportionate measurement, which would place the corner much too far east.

**SURVEYOR'S SEAL**

SIGNED *Kenneth J. Ostling* DATE 7/5/61  
REGISTERED LAND SURVEYOR