

**SURVEY & REMONUMENTATION**

*COMMISSION*  
MAY 03 1995

**COMMISSION**

**CHEBOYGAN COUNTY REMONUMENTATION CORNER  
LAND CORNER RECORDATION CERTIFICATE  
Filing Requirement of Act 74, Mich. P.A. 1970**

DEC 29 1994

RECEIVED FOR RECORD  
at 10:45 o'clock P M

*J. J. J. J.*

CLERK/REGISTER  
CHEBOYGAN COUNTY, MICHIGAN

**Register of Deeds Stamp & File Number**

For corners in

Cheboygan  
(County)

Located In:

Corner Code #

- |                                    |                          |            |
|------------------------------------|--------------------------|------------|
| 1. Public Land Survey              | T <u>35N</u> R <u>1W</u> | <u>A-2</u> |
|                                    | T _____ R _____          | _____      |
|                                    | T _____ R _____          | _____      |
|                                    | T _____ R _____          | _____      |
| 2. Property Controlling in Section | S _____ T _____ R _____  | _____      |
|                                    | S _____ T _____ R _____  | _____      |
| 3. Miscellaneous Property in Sec.  | S _____ T _____ R _____  | _____      |
|                                    | S _____ T _____ R _____  | _____      |

4. Lot No. \_\_\_\_\_, Recorded Plat \_\_\_\_\_  
5. Private Claims \_\_\_\_\_

I, Richard C. Dunn, in a field survey on October, 19 94, do hereby certify that under requirements of P.A. 74, Michigan P.A. of 1970, the corner points mentioned in lines 1 and 2 above were in conformance with regulations and rules therefore as required in the current manual of survey instructions of the United States Department of the Interior, Bureau of Land Management or by a decree of a Court of Law and/or that the corner points mentioned in lines 3, 4 and 5 above were in conformance with the rules of the Michigan Board of Land Surveyors or by a Decree of a Court of Law; established, re-established, monumented, re-monumented, recovered, found as expressed below:

**NOTE: Not more than 4 corners, all in the same town and range, may be recorded on this certificate.**

A	B	C	D	E	F	G	H	I	J	K	L	M
2	6	5	4	3	2	1						
3												
4	7	8	9	10	11	12						
5												
6	18	17	16	15	14	13						
7												
8	19	20	21	22	23	24						
9												
10	30	29	28	27	26	25						
11												
12	31	32	33	34	35	36						
13												

A. Description of original monument and accessories and/or subsequent restoration:


G.L.O. John Mullett 1840  
Set 1/4 Section Post  
14" Beech S55°W 18 Links  
8" S. Maple N85°E 16 Links

Kenneth Ostling #10068, Nov. 18, 1964  
Set 1" Pipe w/4" aluminum cap set by single proportionate measurement, between section corners as recorded in Liber A, Page 389, Cheboygan County Records.  
12" Basswood N03°E 3.3'  
8" Basswood S50°W 19.0'

B. Description of corner evidence found and/or method applied in restoring or reestablishing corner:

A-2 Fnd. 1" Pipe w/4" aluminum cap as recorded in Liber A, Page 389, Cheboygan County Records.

*Martin A. Ray*

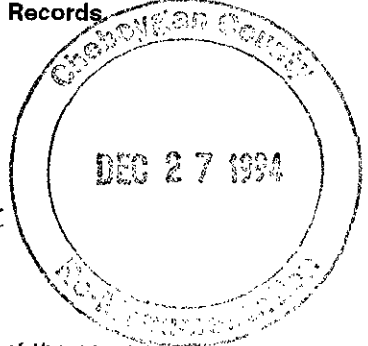

C. Description of monument for corner and accessories established to perpetuate locating the position of the corner:

A-2 Fnd. 1" Pipe w/4" Aluminum cap as recorded in Liber A, Page 389, Cheboygan County Records and is accepted as a careful and faithful reestablishment of the position of the original corner.  
18" Basswood N3°E 4.27'  
12" Tri. Basswood S50°W 19.28'  
18" Beech S28°E 36.05'  
10" Tw. Maple S10°W 28.47'

LIBER 010 PAGE 95



igned by Richard C. Dunn

Date December 15, 1994

urveyor's Michigan License No. 12020